As Built

IREDELL COUNTY HEALTH DEPARTMENT

STATESVILLE 704-878-5305 MOORESVILLE 704-664-5281

IMPROVEMENT PERMIT / AUTHORIZATION TO CONSTRUCT / OPERATION PERMIT / EXISTING SYSTEM INSPECTION

PERMIT# 144229 PIN# 4659068322 DATE 2-12-08

OWNER OR APPLICANT Full Spectrum Realty PHONE: Business Home

ADDRESS 155D S. Eastway Dr. Troutman, NC

LOCATION Hwy 115 N. Sailwinds N. Crystal Bay on left @ intersection of Clear Springs

SUBDIVISION Windward Pt. BLOCK / SECTION 3 LOT 141 LOT AREA .92 Acre SITE CLASS. PS DESIGN FLOW 480gpd T.A.R. .3

Stroup

Septic Tank: 1000 Gallons: STB 786 Date 11-10-07

Pump Tank: Gallons: PT Date

Pump Make: Model Serial No.

Nitrification Field: No Fields 1 Square Feet 1200' Linear Feet 400'

No Lines 4 Trench Width 36" Max Trench Bottom Depth 36 Gravel Depth N/A

☒ New System ☐ Repair ☐ Expansion System Type: I II III IV V VI

System Description: Gravity - 25% Reduction

Repair System Description: Modified - 50-25% Red

Maintenance Agreement Required: ☐ Yes ☒ No

☒ House/Mod. Home ☐ Mobile Home ☐ Business ☐ Other

No. Bedrooms 4 No. Persons No. Employees


Water Supply: ☒ Individual ☐ Public ☐ Community

☒ Gravity ☐ Pressure ☐ Slab ☒ Crawl Space ☐ Basement w/plumbing ☐ Basement wo/plumbing

Comments:/Conditions: * Broke Ground on system prior to 2008

Scale 1:50

INITIAL SITE SKETCH

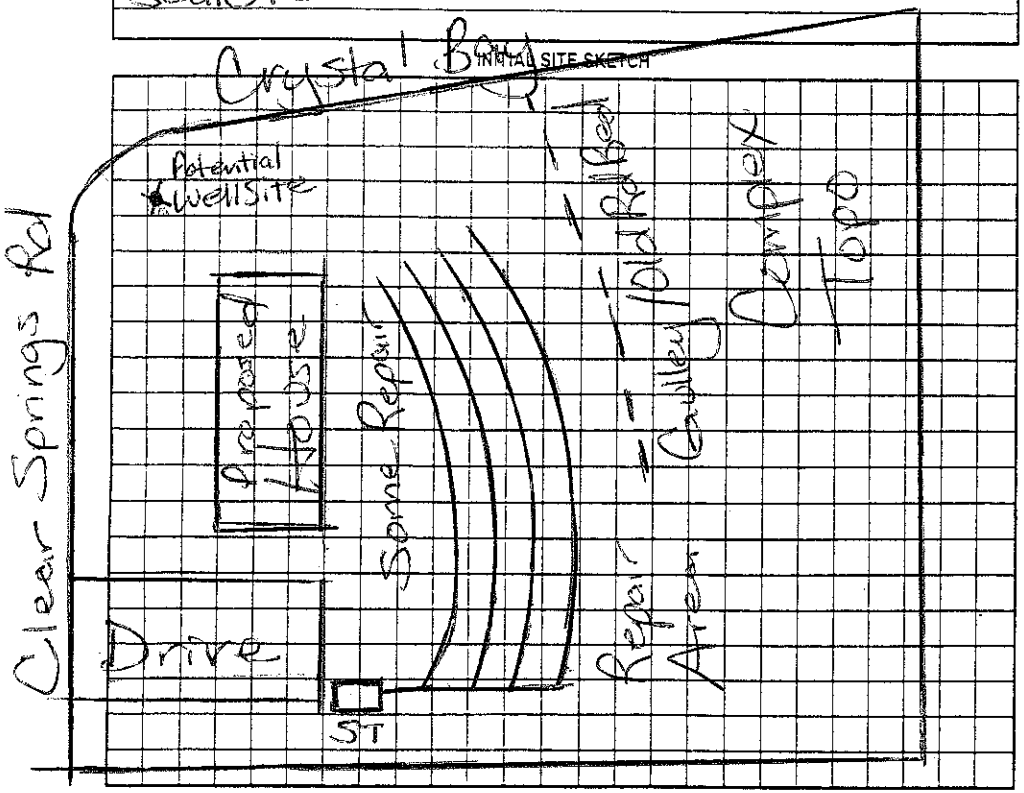

Comments:/Conditions: Blue filter installed & ST marker

AS BUILT SKETCH

Installed Quick 4 Used "built in" drop boxes

Permit can be suspended or revoked if any false information is supplied toward securing the permit/any unauthorized changes are made to the site/any unauthorized changes are made in the installation of the system. Improvement Permit with plat valid without expiration ☐ Improvement Permit with site plan valid for sixty months ☐ Authorization to Construct is valid for a period equal to that of Improvement Permit – not to exceed sixty months.

Signed: date

Improvement Permit by: date

Authorization to Construct by: date

Installed by: Rick's Grading

Operation Permit by: Marian H. Dixon date 2/12/08

Existing System Inspection by: date

HEALTH DEPT. COPY: WHITE OWNER COPY (FINAL): YELLOW OWNER COPY (INITIAL): PINK

IREDELL COUNTY HEALTH DEPARTMENT

STATESVILLE 704-878-5305 MOORESVILLE 704-664-5281

IMPROVEMENT PERMIT / AUTHORIZATION TO CONSTRUCT / OPERATION PERMIT / EXISTING SYSTEM INSPECTION

PERMIT# 144229 PIN# 4659068322 DATE 10-26-07

OWNER OR APPLICANT LPD Windward LLC/Full Spectrum Rea PHONE: Business 400-7019 Home 528-3596

ADDRESS 155 D S. Eastway Dr/ Troutman NC

LOCATION Hwy 115 N TL Sailwinds TL Crystal Bay on left @ intersection of Clear Springs

SUBDIVISION Windward Pt. BLOCK / SECTION ____ LOT 141 LOT AREA .93Acre SITE CLASS. PS DESIGN FLOW 480gpd L.T.A.R. .3

Strout

Septic Tank: 1000 Gallons: STB 786 Date 11-10-07

Pump Tank: ____ Gallons: PT ____ Date ____

Pump Make: ____ Model ____ Serial No. ____

Nitrification Field: No Fields 1 Square Feet 1200' Linear Feet 400'

No Lines 4 Trench Width 36" Max Trench Bottom Depth 36"

☒ New System ☐ Repair ☐ Expansion System Type: I (II) III IV V VI

System Description: Gravity 25% Reduction

Repair System Description: Modified 25-50% Red.

Maintenance Agreement Required: ☐ Yes ☒ No

☒ House/Mod. Home No. Bedrooms 4

☐ Mobile Home No. Persons ____

☐ Business No. Employees ____


☐ Other ____

Water Supply: ☒ Individual ☐ Public ☐ Community

Gravel Depth N/A ☒ Gravity ☐ Pressure ☐ Slab ☐ Crawl Space ☒ Basement w/plumbing ☐ Basement wo/plumbing

Comments/Conditions: Do Not Cut down for basement deeper than drainfield otherwise a pump will be required. Scale 1:50"

INITIAL SITE SKETCH

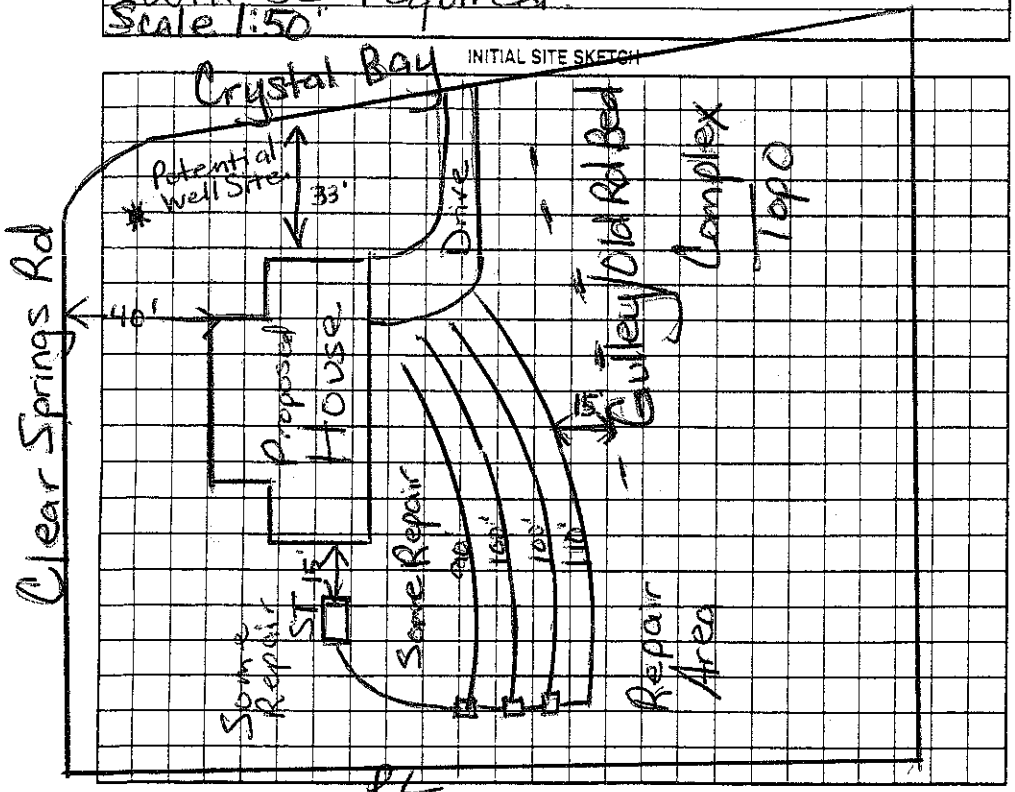

Comments/Conditions: Notes: Keep driveway tight to house, can not cross drainfield Blue filter installed & ST marker

AS BUILT SKETCH

Installed Quick 4 hooked supply line end cap to end cap. See As Built

Permit can be suspended or revoked if any false information is supplied toward securing the permit/any unauthorized changes are made to the site/any unauthorized changes are made in the installation of the system. Improvement Permit with plat valid without expiration ☐ Improvement Permit with site plan valid for sixty months ☐ Authorization to Construct is valid for a period equal to that of Improvement Permit – not to exceed sixty months.

Signed: ____ date 12/5/07 Installed by: Buck's Grading

Improvement Permit by: Maria H. Dolan RS date 10/26/07 Operation Permit by: Maria H. Dolan RS date 2/12/08

Authorization to Construct by: Maria H. Dolan RS date 10/26/07 Existing System Inspection by: ____ date ____

HEALTH DEPT. COPY: WHITE OWNER COPY (FINAL): YELLOW OWNER COPY (INITIAL): PINK