4659068996

~~3.30~~ 11.00

# IREDELL COUNTY HEALTH DEPARTMENT

STATESVILLE 704-878-5305 MOORESVILLE 704-664-5281

## IMPROVEMENT PERMIT / CERTIFICATE OF COMPLETION / OPERATION PERMIT / EXISTING SYSTEM INSPECTION

PROPERTY DESCRIPTION NO. 24894 DATE 2-6-97 TAX MAP NO. 4E A 12 Watershed: ☑ Yes ☐ No

OWNER OR CONTRACTOR Pruitt Development PHONE: Business 875-8001 Home LWSIV C4

ADDRESS 290 Lakeview Dr. Mooresville, N.C.

LOCATION I-21 Turn Sailwind TL Whitewater 3rd lot RT.

SUBDIVISION Windward Pt. BLOCK / SECTION ____ LOT 45 LOT AREA 21780 SITE CLASS. PS DESIGN FLOW 360 L.T.A.R. 1.3

Septic Tank: 1000 Gallons; STB 794 Date 1/10/97

Pump Tank: ____ Gallons; PT ____ Date ____

Pump Make: ____ Model ____ Serial No. ____

Nitrification Field: No Fields 1 Square Feet 900 Linear Feet 300

No Lines 5 Trench Width 36" Max Trench Bottom Depth 36" Gravel Depth N/A

☐ New System ☐ Repair System Type: I, II, (III), IV, V, VI

System Description: Gravity Chambers

Repair System Description: " Panels

Maintenance Agreement Required: ☐ Yes ☐ No

☐ House/Mod. Home No. Bedrooms 3

☑ Mobile Home No. Bathrooms 2

☐ Business No. Employees ____

☐ Other ____


☐ Slab ☑ Crawl Space ☐ Basement w/plumbing ☐ Basement wo/plumbing

Water Supply: ☑ Individual ☐ Community ☐ Public


Comments:

Comments: WELL NOT LOCATED AT TIME OF INSPECTION

INITIAL SITE SKETCH

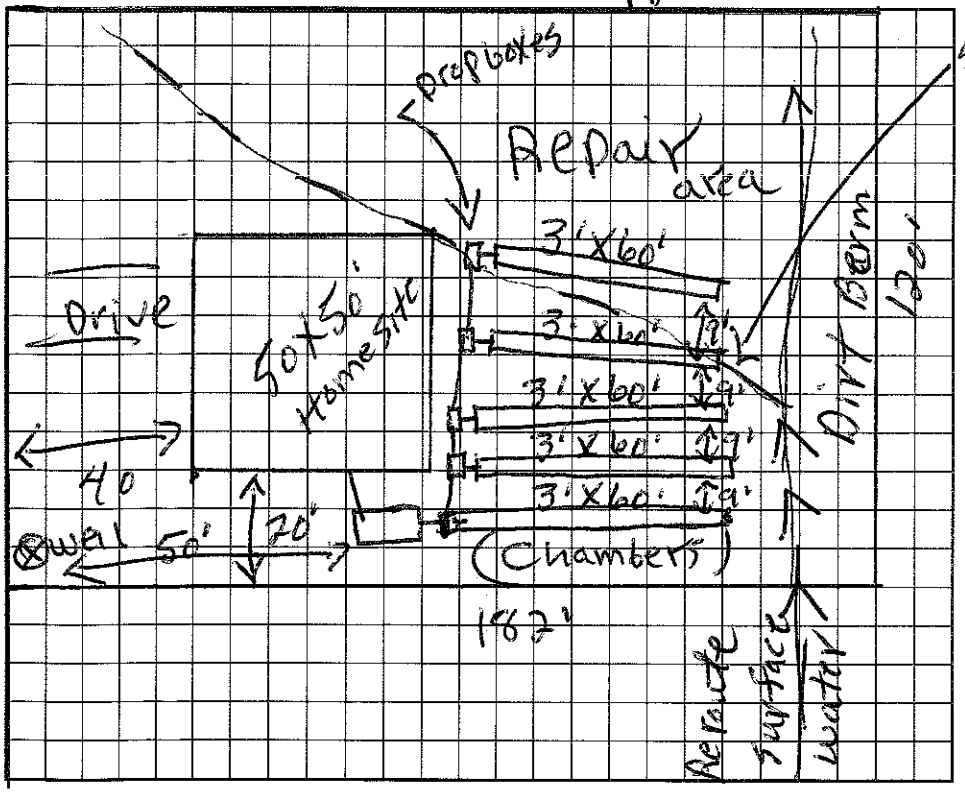


AS BUILT SKETCH

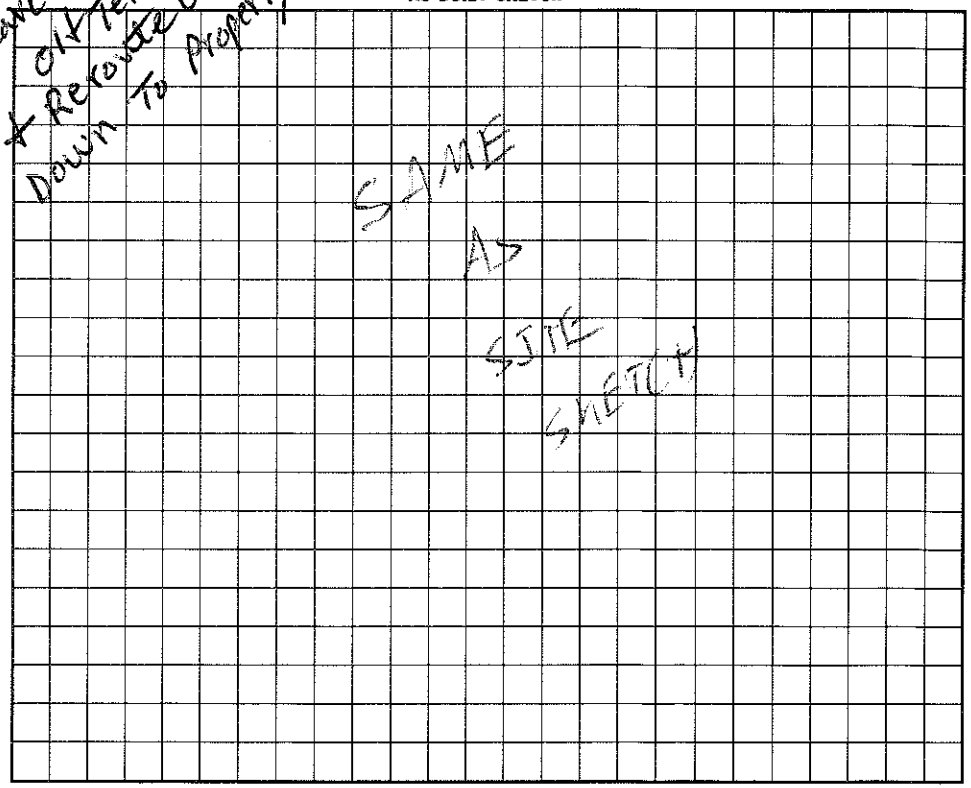


I understand that this permit can be suspended or revoked if any false information is supplied toward securing the permit/any unauthorized changes are made to the site/any unauthorized changes are made in the installation of the system. Improvement Permit is valid for 60 months from date of issuance.

Signed: ____

Installed by: Tim Ammons

Improvement Permit by: P.C. Moore date 2-6-97

Authorization to Existing System Inspection by: P.C. Moore date 2-6-97

Certificate of Completion by: ____ date ____

Operation Permit by: C. [illegible] date 4/10/97

HEALTH DEPT. COPY: WHITE INSPECTION COPY (FINAL): GREEN OWNER COPY (FINAL): YELLOW INSPECTION COPY (INITIAL): PINK OWNER COPY (INITIAL): GOLD