IREDELL COUNTY HEALTH DEPARTMENT

4659069733

STATESVILLE 704-878-5305 MOORESVILLE 704-664-5281

IMPROVEMENT PERMIT / AUTHORIZATION TO CONSTRUCT / OPERATION PERMIT / EXISTING SYSTEM INSPECTION

PERMIT# 24896 PIN# 4EA12

OWNER OR CONTRACTOR Pruitt Deve

ADDRESS 142 Struts Rd Mooresville NC PHONE: Business 1-800-722-3633 Home DATE 4/13/98

LOCATION 21 to Sailwinds Tr on Waterwitch Lot end on Rt

SUBDIVISION Windward Pt BLOCK / SECTION 1 LOT 41 LOT AREA 21780 SITE CLASS. 15 DESIGN FLOW 360gpd L.T.A.R. .3

Septic Tank: 1000 Gallons; STB 1612 Date 3/3/98

Pump Tank: Gallons; PT Date

Pump Make: Model Serial No.

Nitrification Field: No Fields 1 Square Feet 1200' Linear Feet 400'

No Lines 8 at 50' Trench Width 36" Max Trench Bottom Depth 36" Gravel Depth 12"

☒ New System ☐ Repair System Type: I, II, III, IV, V, VI

System Description: Gravity Conventional

Repair System Description: Grav. - Modified

Maintenance Agreement Required: ☐ Yes ☒ No

☐ House/Mod. Home ☒ Mobile Home ☐ Business ☐ Other

No. Bedrooms 3 No. Bathrooms 2 No. Employees


☐ Slab ☒ Crawl Space ☐ Basement w/plumbing ☐ Basement wo/plumbing

Water Supply: ☒ Individual ☐ Public ☐ Community


Comments:/Conditions: Keep Septic System at least 10' from PL, 5' from Mtr & at least 50' from well. Installer can use "Deep boxes" or flow divider to 2 separate Distribution boxes

Comments:/Conditions: 4 lines 75' x 3' installed Well not installed when final performed.

INITIAL SITE SKETCH Scale: 1:50

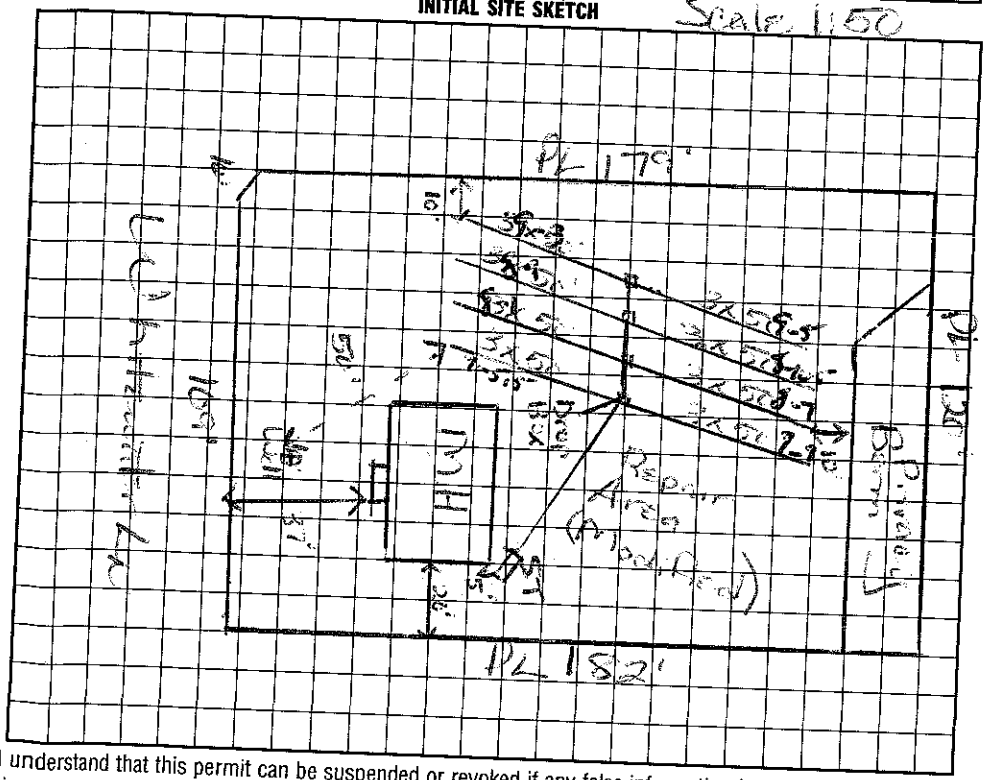

AS-BUILT SKETCH

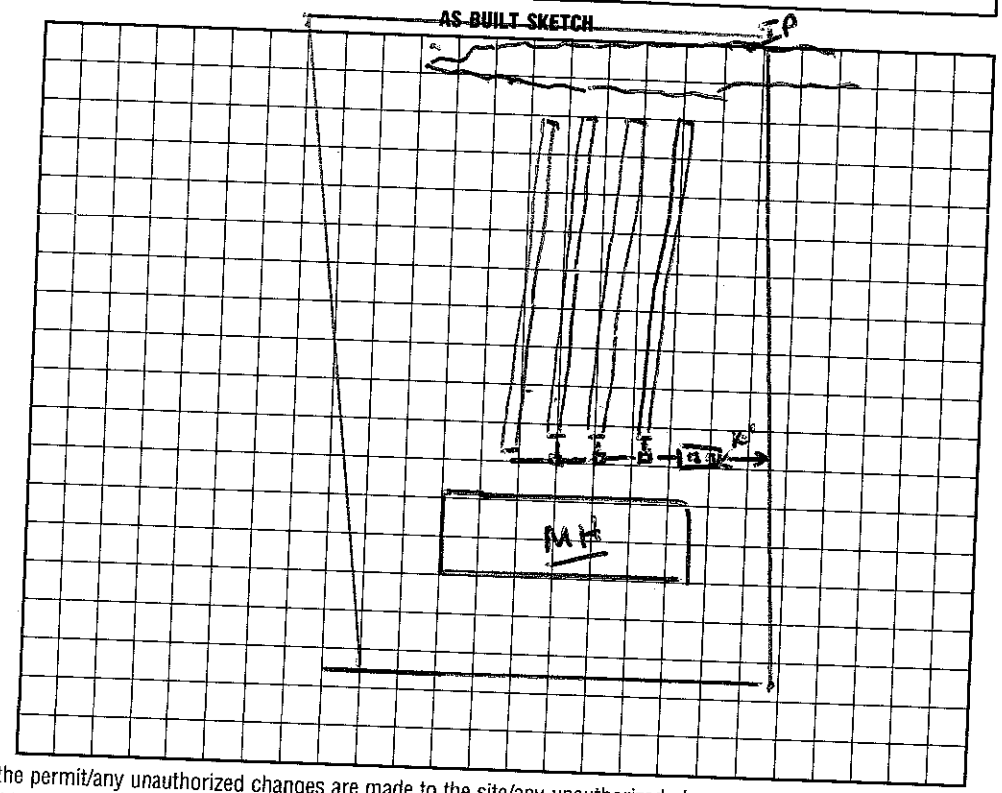

I understand that this permit can be suspended or revoked if any false information is supplied toward securing the permit/any unauthorized changes are made to the site/any unauthorized changes are made in the installation of the system. Improvement Permit with plat valid without expiration. Improvement Permit with site plan valid for sixty months. Authorization to Construct is valid for a period equal to that of Improvement Permit – not to exceed sixty months.

Signed:

Improvement Permit by: Maria H. Watson date 4/14/98

Authorization to Construct by: Maria H. Watson date 4/14/98

Installed by: A-1 Backhoe

Operation Permit by: Wesley Sparks date 6/18/98

Existing System Inspection by: date

HEALTH DEPT. COPY: WHITE INSPECTION COPY (FINAL): GREEN OWNER COPY (FINAL): YELLOW INSPECTION COPY (INITIAL): PINK OWNER COPY (INITIAL): GOLD