IREDELL COUNTY HEALTH DEPARTMENT Const. Auth. STATESVILLE 704-878-5305 MOORESVILLE 704-664-5281

IMPROVEMENT PERMIT / ~~CERTIFICATE OF COMPLETION~~ / OPERATION PERMIT / EXISTING SYSTEM INSPECTION

PROPERTY DESCRIPTION NO. 24895 DATE Feb 27 '97 TAX MAP NO. part of 4EA12 Watershed: ☑ Yes ☐ No

OWNER OR CONTRACTOR Quality Dev. Co. PHONE: Business _____ Home _____

ADDRESS 142 Stutts Rd. Mooresville

LOCATION 21 N. TL Statesville TL Whitewater Cr. on Right

SUBDIVISION Windward Pt. BLOCK / SECTION _____ LOT 46 LOT AREA 120'x182' SITE CLASS 5 per 1956 DESIGN FLOW 360 gpd L.T.A.R. .3

Septic Tank: 1000 Gallons; STB 821 Date 2/28/97

Pump Tank: _____ Gallons; PT _____ Date _____

Pump Make: _____ Model _____ Serial No. _____

Nitrification Field: No Fields 2 Square Feet 900 Linear Feet 300

No Lines 3+3 Trench Width 36" Max Trench Bottom Depth 36" Gravel Depth N/A

☑ New System ☐ Repair System Type: I, II, III, IV, V, VI

System Description: gravity plastic chamber

Repair System Description: grid panel block

Maintenance Agreement Required: ☐ Yes ☑ No

☐ House/Mod. Home ☑ Mobile Home ☐ Business ☐ Other

No. Bedrooms 3 No. Bathrooms 2 No. Employees _____


☐ Slab ☑ Crawl Space ☐ Basement w/plumbing ☐ Basement wo/plumbing

Water Supply: ☑ Individual ☐ Community ☐ Public

Comments:

Comments:

INITIAL SITE SKETCH 1"=50'

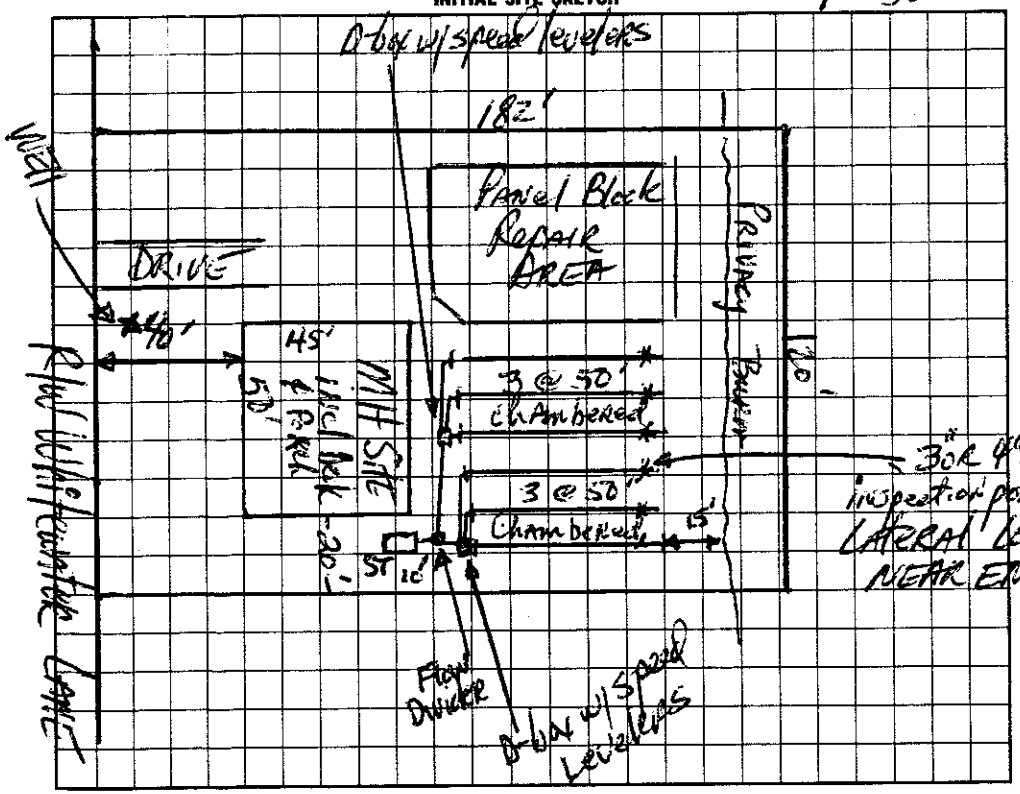

AS BUILT SKETCH

I understand that this permit can be suspended or revoked if any false information is supplied toward securing the permit/any unauthorized changes are made to the site/any unauthorized changes are made in the installation of the system. Improvement Permit is valid for 60 months from date of issuance.

Signed: ★

Improvement Permit by: _____ date 2/27/97

~~Existing System Inspection by:~~ Construction Authorization _____ date 2/27/97

Installed by: J+M Enterprises

Certificate of Completion by: _____ date 4/1/97

Operation Permit by: _____ date 4/1/97

HEALTH DEPT. COPY: WHITE INSPECTION COPY (FINAL): GREEN OWNER COPY (FINAL): YELLOW INSPECTION COPY (INITIAL): PINK OWNER COPY (INITIAL): GOLD