Permit # 66095 2.00

IREDELL COUNTY HEALTH DEPARTMENT STATESVILLE 704-878-5305 MOORESVILLE 704-664-5281

IMPROVEMENT PERMIT / ~~CERTIFICATE OF COMPLETION~~ / OPERATION PERMIT / EXISTING SYSTEM INSPEC

PROPERTY DESCRIPTION NO. 24867 DATE April 2, '97 TAX MAP NO. part of 4E412 - Lot 18 Watershed: ☑ Yes ☐ No

OWNER OR CONTRACTOR Pruitt Dev. Co. PHONE: Business 4659 07 0044 Home

ADDRESS 142 Stella RD. Mooresville

LOCATION 115-21 N. to Sailwinds TR Keyside LN. immediately on Rt - corner lot

SUBDIVISION Windward Pt. BLOCK / SECTION LOT 18 LOT AREA ~120 X 175' SITE CLASS. PS DESIGN FLOW 360gpd L.T.A.R. .3

Septic Tank: 1000 Gallons; STB 794 Date 2/6/97

Pump Tank: 1000 Gallons; PT 27 Date 3/10/97

Pump Make: HYDROMATIC Model SK50 Serial No.

Nitrification Field: No Fields 1 Square Feet 1200 Linear Feet 400

No Lines 4 @ 100' Trench Width 36" Max Trench Bottom Depth (18") Gravel Depth 12"

☑ New System ☐ Repair System Type: I, II, (III), IV, V, VI

System Description: pumped-pm- SHALLOW CONVENTIONAL

Repair System Description: pumped pm - Chambered

Maintenance Agreement Required: ☐ Yes ☑ No

☐ House/Mod. Home No. Bedrooms 3

☑ Mobile Home No. Bathrooms 2

☐ Business No. Employees

☐ Other

☐ Slab ☑ Crawl Space ☐ Basement w/plumbing ☐ Basement wo/plumbing


Water Supply: ☑ Individual ☐ Community ☐ Public

Comments: X Septic System Installer NOTE trench bottom depth


Comments: LINES, TANKS, PRESSURE CHECKED

1" = 50'

INITIAL SITE SKETCH

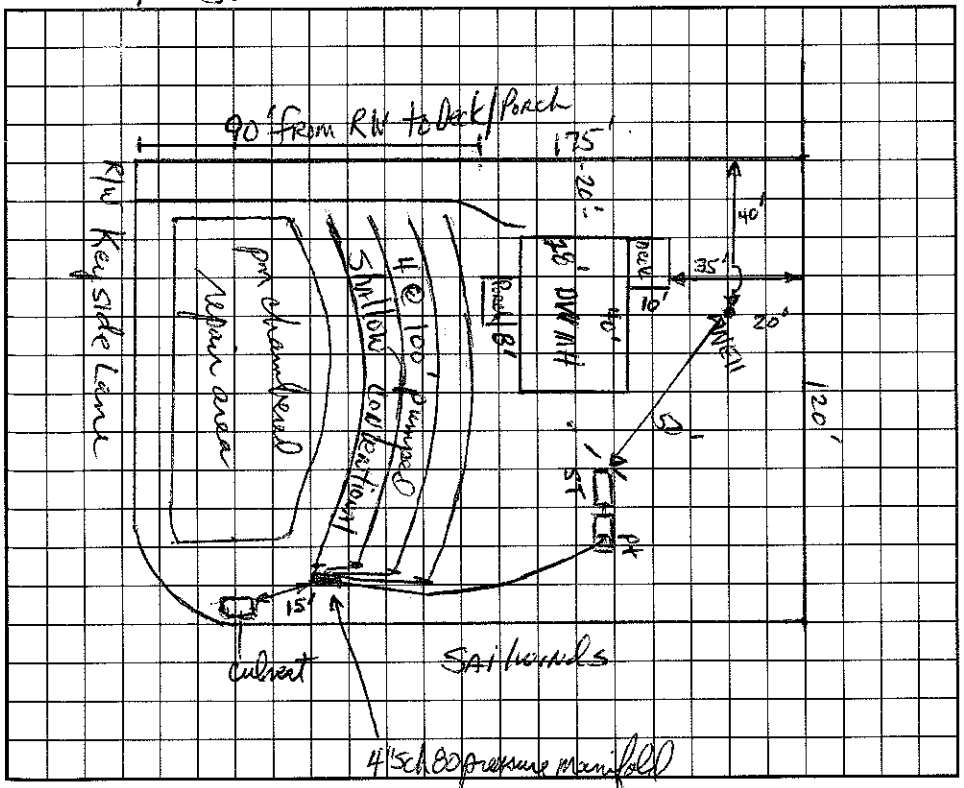

AS BUILT SKETCH

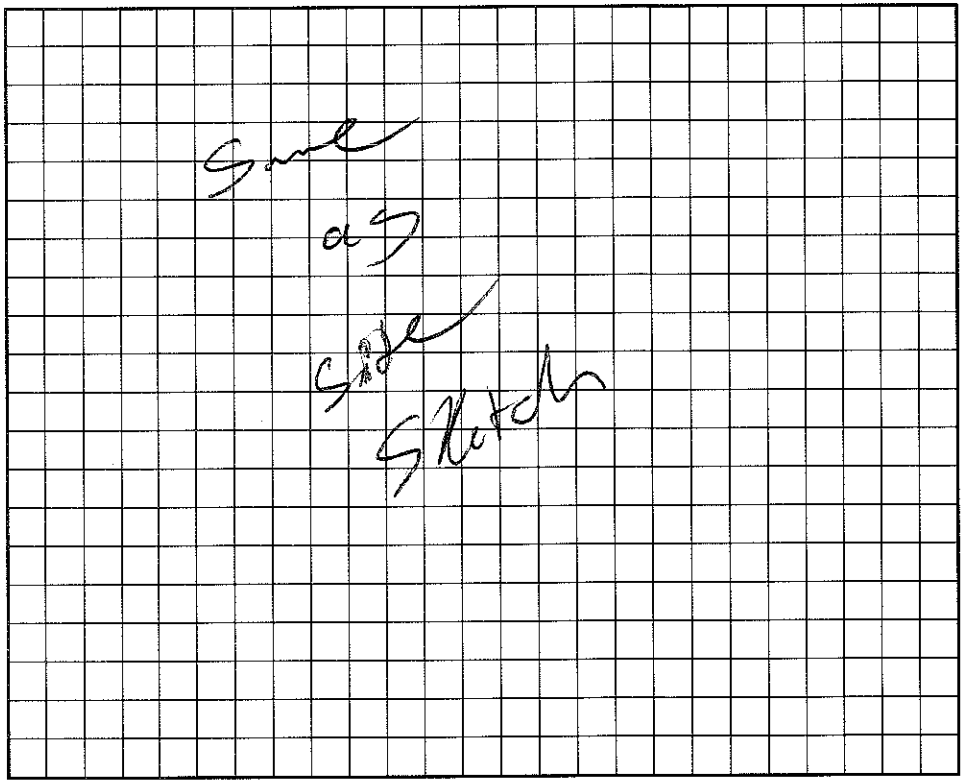

I understand that this permit can be suspended or revoked if any false information is supplied toward securing the permit/any unauthorized changes are made to the site/any unauthorized changes are made in the installation of the system. Improvement Permit is valid for 60 months from date of issuance.

Signed:

Improvement Permit by: Warren Thomas, RS date 4/2/97

~~Existing System Inspection by:~~ CONSTRUCTION Authorization: Thomas, RS date 4/2/97

Installed by: TIM AMMONS

Certificate of Completion by: date

Operation Permit by: C. Bridges date 1/23/98

HEALTH DEPT. COPY: WHITE INSPECTION COPY (FINAL): GREEN OWNER COPY (FINAL): YELLOW INSPECTION COPY (INITIAL): PINK OWNER COPY (INITIAL): GOLD