IREDELL COUNTY HEALTH DEPARTMENT

AUTHORIZATION TO CONSTRUCT

4659071205

STATESVILLE 704-878-5305 MOORESVILLE 704-664-5281

IMPROVEMENT PERMIT / ~~CERTIFICATE OF COMPLETION~~ / OPERATION PERMIT / EXISTING SYSTEM INSPECTION

PROPERTY DESCRIPTION NO. 24865 DATE 6/10/97 TAX MAP NO. 4E A 12 Watershed: ☐ ~~Yes~~ ☐ No

OWNER OR CONTRACTOR PRUITT DEVELOPMENT PHONE: Business 875-8001 Home

ADDRESS 290 LAKEVIEW DR MOORESVILLE NC 28115

LOCATION 21 N - TL SAILWINDS - 16TH LOT ON RT

SUBDIVISION WINWARD PT BLOCK / SECTION 1 LOT 16 LOT AREA 21780 SITE CLASS. PS DESIGN FLOW 360 gpd L.T.A.R. .3 gpd/ft²

Septic Tank: 1000 Gallons; STB 1012 Date 4/11/97

Pump Tank: Gallons; PT Date

Pump Make: Model Serial No.

Nitrification Field: No Fields 1 Square Feet 900 Linear Feet 300

No Lines 5 @ 60 Trench Width 36" Max Trench Bottom Depth 30" Gravel Depth N/A

☑ New System ☐ Repair System Type: I, II, III, IV, V, VI

System Description: GRAVITY CHAMBERED

Repair System Description: PUMP PANEL

Maintenance Agreement Required: ☐ Yes ☑ No

☐ House/Mod. Home No. Bedrooms 3

☑ Mobile Home No. Bathrooms 2

☐ Business No. Employees

☐ Other


☐ Slab ☑ Crawl Space ☐ Basement w/plumbing ☐ Basement wo/plumbing

Water Supply: ☑ Individual ☐ Community ☐ Public

Comments:

Comments:

INITIAL SITE SKETCH 1" = 50'

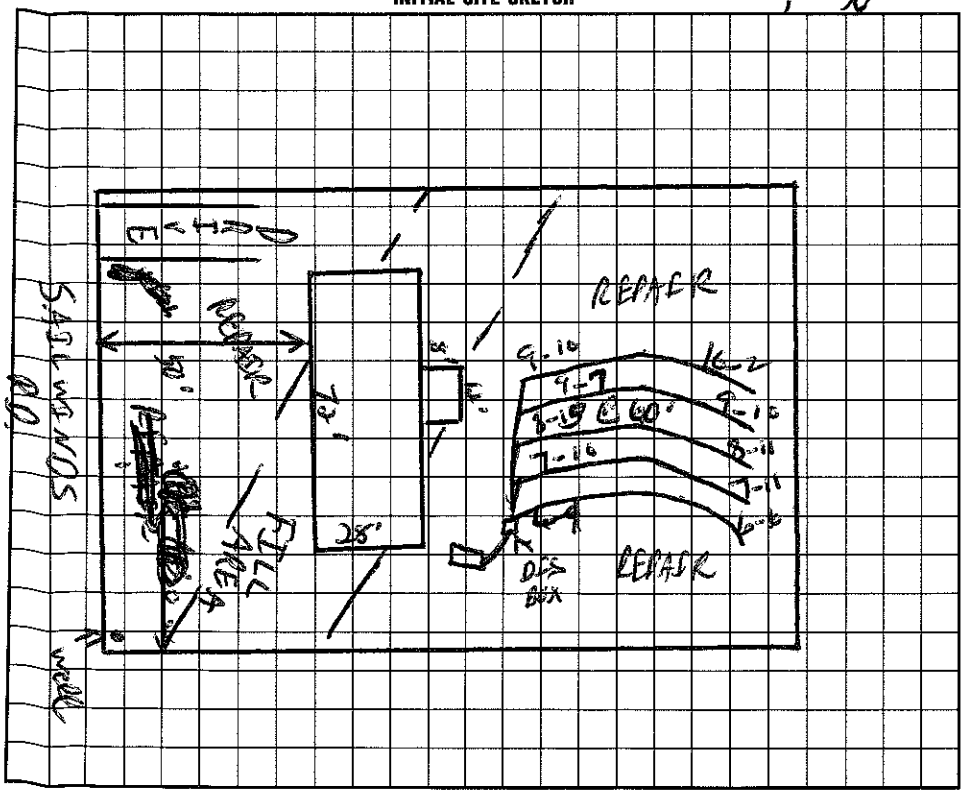

AS BUILT SKETCH

I understand that this permit can be suspended or revoked if any false information is supplied toward securing the permit/any unauthorized changes are made to the site/any unauthorized changes are made in the installation of the system. Improvement Permit is valid for 60 months from date of issuance.

Signed: Russell Lazor

Improvement Permit by: [signature] date 6/10/97

AUTHORIZATION TO CONSTRUCT

~~Existing System Inspection~~ by: [signature] date 6/10/97

Installed by: A-1 Backhoe

Certificate of Completion by: Wesley Sparks RS. date 6/16/97

Operation Permit by: Wesley Sparks RS. date 6/16/97

HEALTH DEPT. COPY: WHITE INSPECTION COPY (FINAL): GREEN OWNER COPY (FINAL): YELLOW INSPECTION COPY (INITIAL): PINK OWNER COPY (INITIAL): GOLD