IREDELL COUNTY HEALTH DEPARTMENT

STATESVILLE 704-878-5305 MOORESVILLE 704-664-5281

IMPROVEMENT PERMIT / AUTHORIZATION TO CONSTRUCT / OPERATION PERMIT / EXISTING SYSTEM INSPECTION

PERMIT# 24879 PIN# 4E A12 9659072039 DATE 2-10-98

OWNER OR CONTRACTOR Pruitt Development PHONE: Business (704) 875-0081 Home

ADDRESS 124 Kirkwall Pl Mooresville, NC 28115

LOCATION Hwy 115/US 21 N TL Sailwinds TL Keyside on Corner

SUBDIVISION Edward Pt BLOCK / SECTION I LOT 30 LOT AREA 21,780 SQ FT SITE CLASS. PS DESIGN FLOW 360 gpd L.T.A.R. .3

Septic Tank: 1000 Gallons; STB 1012 Date 12/11/97

Pump Tank: Gallons; PT Date

Pump Make: Model Serial No.

Nitrification Field: No Fields 1 Square Feet *900' Linear Feet *300'

No Lines 4 at 75' Trench Width 36" Max Trench Bottom Depth 24" Gravel Depth N/A

☒ New System ☐ Repair System Type: I, II, (III), IV, V, VI

System Description: Grav. Plastic Chamber or Similar

Repair System Description: Pump/Grav. Pl. Cham. or Similar

Maintenance Agreement Required: ☐ Yes ☒ No

☐ House/Mod. Home No. Bedrooms 3

☒ Mobile Home No. Bathrooms 2

☐ Business No. Employees

☐ Other


☐ Slab ☒ Crawl Space ☐ Basement w/plumbing ☐ Basement wo/plumbing

Water Supply: ☒ Individual ☐ Public ☐ Community

Comments:/Conditions: * 25% Reduction in Drainfield Area. Keep Drainfield/Septic Tank atleast 5' from House, 10' from Property lines & 50' from any well.

Comments:/Conditions:

INITIAL SITE SKETCH Scale 1:50

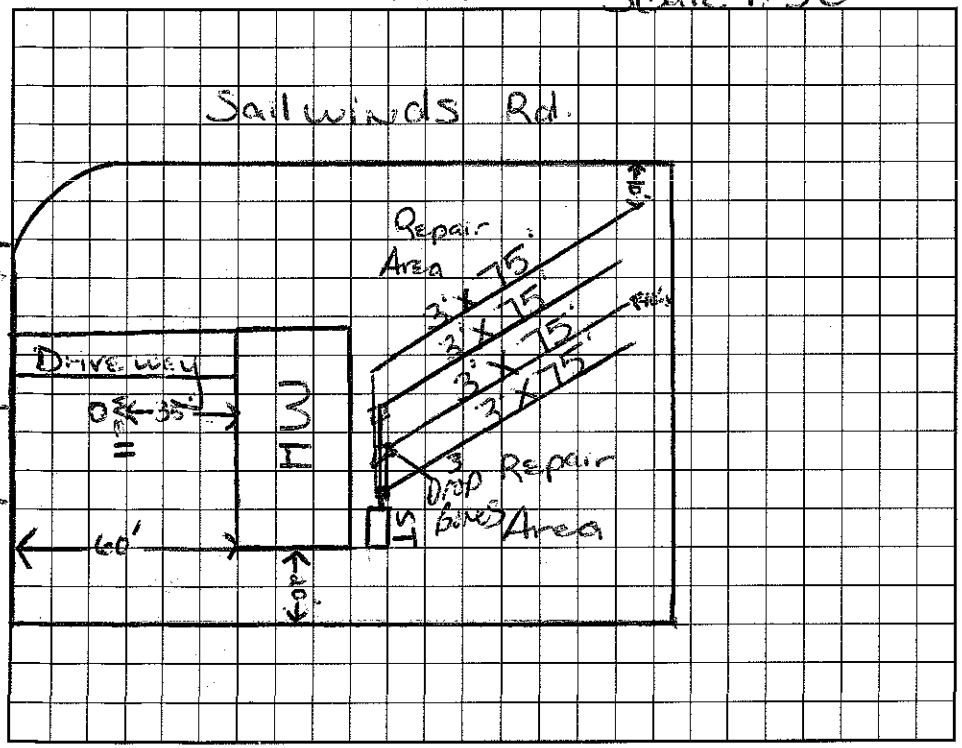

AS BUILT SKETCH

I understand that this permit can be suspended or revoked if any false information is supplied toward securing the permit/any unauthorized changes are made to the site/any unauthorized changes are made in the installation of the system. Improvement Permit with plat valid without expiration. Improvement Permit with site plan valid for sixty months. Authorization to Construct is valid for a period equal to that of Improvement Permit – not to exceed sixty months.

Signed: date 2/24/98 Installed by: A1 Backhoe

Improvement Permit by: Maria H. Dotson date 2/10/98 Operation Permit by: date 3/5/98

Authorization to Construct by: Maria H. Dotson date 2/10/98 Existing System Inspection by: C. date 3/5/98

HEALTH DEPT. COPY: WHITE INSPECTION COPY (FINAL): GREEN OWNER COPY (FINAL): YELLOW INSPECTION COPY (INITIAL): PINK OWNER COPY (INITIAL): GOLD