IREDELL COUNTY HEALTH DEPARTMENT

4659074152 (2:30)

STATESVILLE 704-878-5305 MOORESVILLE 704-664-5281

IMPROVEMENT PERMIT / CERTIFICATE OF COMPLETION / OPERATION PERMIT / EXISTING SYSTEM INSPECTION

PROPERTY DESCRIPTION NO. 24880 DATE 2-6-97 TAX MAP NO. 4E-A-17 Watershed: ☐ Yes ☐ No

OWNER OR CONTRACTOR Pruett Development PHONE: Business 875 3001 Home

ADDRESS 290 Lakeview Dr. Mooresville, N.C. WSIV-CA

LOCATION 21S Turn Sailwart Rd TL Crystal Bay 1ST lot RT

SUBDIVISION Windward Pt. BLOCK / SECTION LOT 31 LOT AREA 1.48 acres SITE CLASS. 105 DESIGN FLOW 360 L.T.A.R. .3

Septic Tank: 1000 Gallons; STB 1012 Date 11/19/97

Pump Tank: Gallons; PT Date

Pump Make: Model Serial No.

Nitrification Field: No Fields 1 Square Feet 900 Linear Feet 300

No Lines 4 Trench Width 3'11" Max Trench Bottom Depth 36" Gravel Depth N/A

☑ New System ☐ Repair System Type: I, II, III, IV, V, VI

System Description: Gravity Chambers

Repair System Description: 11 Panels

Maintenance Agreement Required: ☐ Yes ☐ No

☐ House/Mod. Home ☐ Mobile Home ☐ Business ☐ Other

No. Bedrooms 3 No. Bathrooms 2 No. Employees


☐ Slab ☐ Crawl Space ☐ Basement w/plumbing ☐ Basement wo/plumbing

Water Supply: ☐ Individual ☐ Community ☐ Public

Comments:

Comments: TANK LOCATION CHANGED. 4@75' INSTALLED.

INITIAL SITE SKETCH

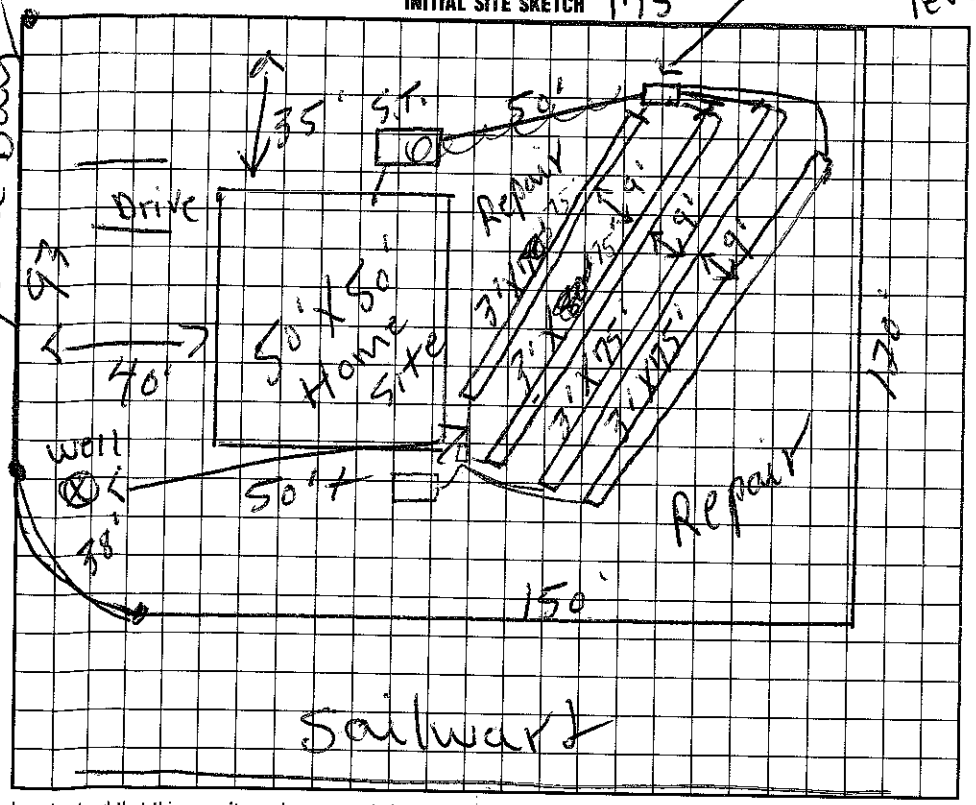

AS BUILT SKETCH

I understand that this permit can be suspended or revoked if any false information is supplied toward securing the permit/any unauthorized changes are made to the site/any unauthorized changes are made in the installation of the system. Improvement Permit is valid for 60 months from date of issuance.

Signed:

Improvement Permit by: P.C. moore date 2-6-97

Existing System Inspection by: P.C. moore date 2-6-97

Installed by: A-1 BACKHOE

Certificate of Completion by: date

Operation Permit by: C [illegible] date 3/2/98

authorization to cover

HEALTH DEPT. COPY: WHITE INSPECTION COPY (FINAL): GREEN OWNER COPY (FINAL): YELLOW INSPECTION COPY (INITIAL): PINK OWNER COPY (INITIAL): GOLD