4659076126

IREDELL COUNTY HEALTH DEPARTMENT Const. Auth STATESVILLE 704-878-5305 MOORESVILLE 704-664-5281

IMPROVEMENT PERMIT / ~~CERTIFICATE OF COMPLETION~~ / OPERATION PERMIT / EXISTING SYSTEM INSPECTION

PROPERTY DESCRIPTION NO. 24891 DATE Jan-15,'97 TAX MAP NO. part of 4EA12 Watershed: ☑ Yes ☐ No

OWNER OR CONTRACTOR Truitt Dev. Co. PHONE: Business _____ Home _____

ADDRESS 13420 Rease Blvd. W. Huntersville

LOCATION 115-21 N. TL Sailwinds TL Crystal Bay Dr. on left - corner Lot

SUBDIVISION Windward Pt. BLOCK / SECTION _____ LOT 42 LOT AREA ~120'x175' SITE CLASS. PSep. 1996 DESIGN FLOW 360gpd L.T.A.R. .3

Septic Tank: 1000 Gallons; STB 1017 Date _____

Pump Tank: _____ Gallons; PT _____ Date _____

Pump Make: _____ Model _____ Serial No. _____

Nitrification Field: No Fields 1 Square Feet 900 Linear Feet 300

No Lines 3@100' Trench Width 36" Max Trench Bottom Depth 36" Gravel Depth NA

☑ New System ☐ Repair System Type: I, II, III, IV, V, VI

System Description: gravity plastic chambered

Repair System Description: pumped chambered

Maintenance Agreement Required: ☐ Yes ☑ No

☐ House/Mod. Home ☑ Mobile Home ☐ Business ☐ Other

No. Bedrooms 3 No. Bathrooms 2 No. Employees _____

☐ Slab ☑ Crawl Space ☐ Basement w/plumbing ☐ Basement wo/plumbing


Water Supply: ☑ Individual ☐ Community ☐ Public

Comments: Must exit plumbing at existing grade in order to avoid use of a pump.

Comments: No well!

1"=50'

INITIAL SITE SKETCH

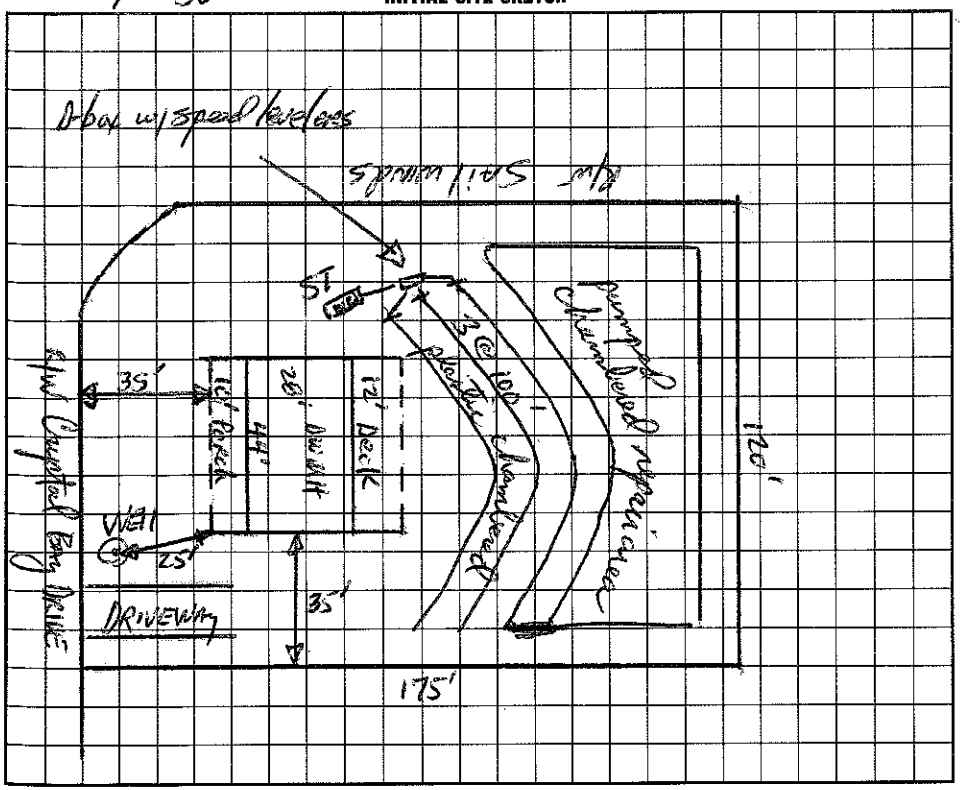

AS BUILT SKETCH

I understand that this permit can be suspended or revoked if any false information is supplied toward securing the permit/any unauthorized changes are made to the site/any unauthorized changes are made in the installation of the system. Improvement Permit is valid for 60 months from date of issuance.

Signed: _____

Improvement Permit by: Mark R. Hunter, IRS date Jan 15,'97

~~Existing system inspection~~ CONSTRUCTION by: M R Hunter, IRS date 1-15-97

Installed by: Dennis Baldwin

Certificate of Completion by: Wesley Sparks RS date 6/6/97

Operation Permit by: Wesley Sparks RS date 6/6/97

As Recorded

HEALTH DEPT. COPY: WHITE INSPECTION COPY (FINAL): GREEN OWNER COPY (FINAL): YELLOW INSPECTION COPY (INITIAL): PINK OWNER COPY (INITIAL): GOLD