IREDELL COUNTY HEALTH DEPARTMENT

Construction Auth. 4659076397

STATESVILLE 704-878-5305 MOORESVILLE 704-664-5281

IMPROVEMENT PERMIT / ~~CERTIFICATE OF COMPLETION~~ / OPERATION PERMIT / EXISTING SYSTEM INSPECTION

PROPERTY DESCRIPTION NO. 24860 DATE 6/2/97 TAX MAP NO. part of 4E412 Watershed: [X] Yes [ ] No

OWNER OR CONTRACTOR Pruitt Dev. Co. PHONE: Business (800)722-3633 Home

ADDRESS 142 Stutts Rd Mooresville, NC

LOCATION US 115/21 N. to Sailwinds on Right

SUBDIVISION Windward Pt BLOCK / SECTION LOT 11 LOT AREA 120' x 175' SITE CLASS P.S. DESIGN FLOW 360gpd L.T.A.R. .3

Septic Tank: 1000 Gallons; STB 1012 Date 4/13/97

Pump Tank: Gallons; PT Date

Pump Make: Model Serial No.

Nitrification Field: No Fields 1 Square Feet 900' Linear Feet 300'

No Lines 3 at 100' Trench Width 3' Max Trench Bottom Depth 30" Gravel Depth N/A

[X] New System [ ] Repair System Type: I, II, (III), IV, V, VI

System Description: Gravity plastic Chamber

Repair System Description: Gravity panel blk

Maintenance Agreement Required: [ ] Yes [ ] No

[X] House/Mod. Home No. Bedrooms 3

[ ] Mobile Home No. Bathrooms 2

[ ] Business No. Employees

[ ] Other

[ ] Slab [X] Crawl Space [ ] Basement w/plumbing [ ] Basement wo/plumbing


Water Supply: [X] Individual [ ] Community [ ] Public

Comments: Maintain at least 15' from silt pond unless properly filled — then setback is 5'.

* Install inspection ports near end of each line.

Comments:

INITIAL SITE SKETCH Scale 1": 50'

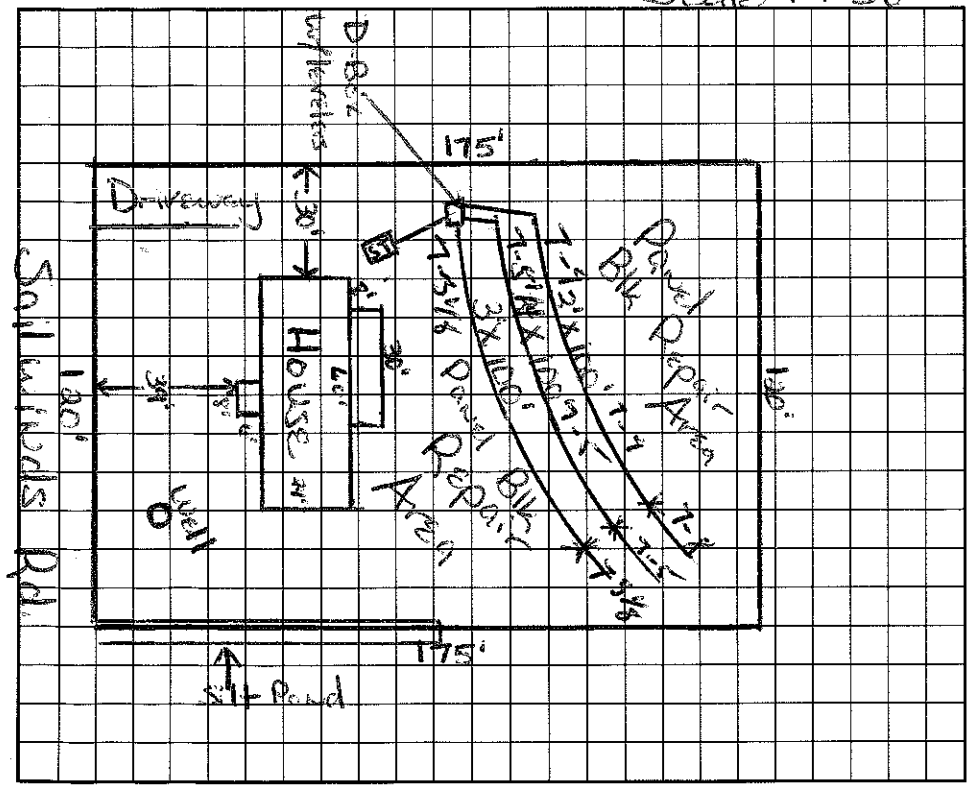

AS BUILT SKETCH

I understand that this permit can be suspended or revoked if any false information is supplied toward securing the permit/any unauthorized changes are made to the site/any unauthorized changes are made in the installation of the system. Improvement Permit is valid for 60 months from date of issuance.

Signed:

Improvement Permit by: Maria H. H. Dotson date 6/2/97

~~Existing System~~ Inspection by: Maria H. H. Dotson date 6/2/97

Installed by: A-1 Backhoe

Certificate of Completion by: Wesley Sparks R.S. date 6/16/97

Operation Permit by: Wesley Sparks R.S. date 6/16/97

Const. Auth.

HEALTH DEPT. COPY: WHITE INSPECTION COPY (FINAL): GREEN OWNER COPY (FINAL): YELLOW INSPECTION COPY (INITIAL): PINK OWNER COPY (INITIAL): GOLD