IREDELL COUNTY HEALTH DEPARTMENT

Const Auth 4659078240

STATESVILLE 704-878-5305 MOORESVILLE 704-664-5281

IMPROVEMENT PERMIT / CERTIFICATE OF COMPLETION / OPERATION PERMIT / EXISTING SYSTEM INSPECTION

PROPERTY DESCRIPTION NO. 24892 DATE 6/24/97 TAX MAP NO. 4E A12 Watershed: ☒ Yes ☐ No

OWNER OR CONTRACTOR Pruitt Dev. Co. PHONE: Business _____ Home _____

ADDRESS 142 Stutts Rd Mooresville NC

LOCATION 21 N to Gailwinds TL Whitewater Ln TL

SUBDIVISION Windward Pt BLOCK / SECTION _____ LOT 43 LOT AREA _____ SITE CLASS. PS DESIGN FLOW 360 gpd L.T.A.R. .25 - .3

Septic Tank: _____ Gallons; STB 1012 Date 1/19/97

Pump Tank: _____ Gallons; PT _____ Date _____

Pump Make: _____ Model _____ Serial No. _____

Nitrification Field: No Fields 1 Square Feet 1080' Linear Feet 360'

No Lines 4 at 90' Trench Width 36" Max Trench Bottom Depth N36" Gravel Depth N/A

☒ New System ☐ Repair System Type: I, II, (III) IV, V, VI

System Description: Gravity Plastic Chamber

Repair System Description: Gravity Paved Bik

Maintenance Agreement Required: ☐ Yes ☒ No

☒ House/Mod. Home No. Bedrooms 3

☐ Mobile Home No. Bathrooms 2

☐ Business No. Employees _____

☐ Other _____


☐ Slab ☒ Crawl Space ☐ Basement w/plumbing ☐ Basement wo/plumbing

Water Supply: ☒ Individual ☐ Community ☐ Public

Comments: X Install inspection ports at end of each lateral

Comments: Approved for 3 BDRM MH.

INITIAL SITE SKETCH Scale 1:50

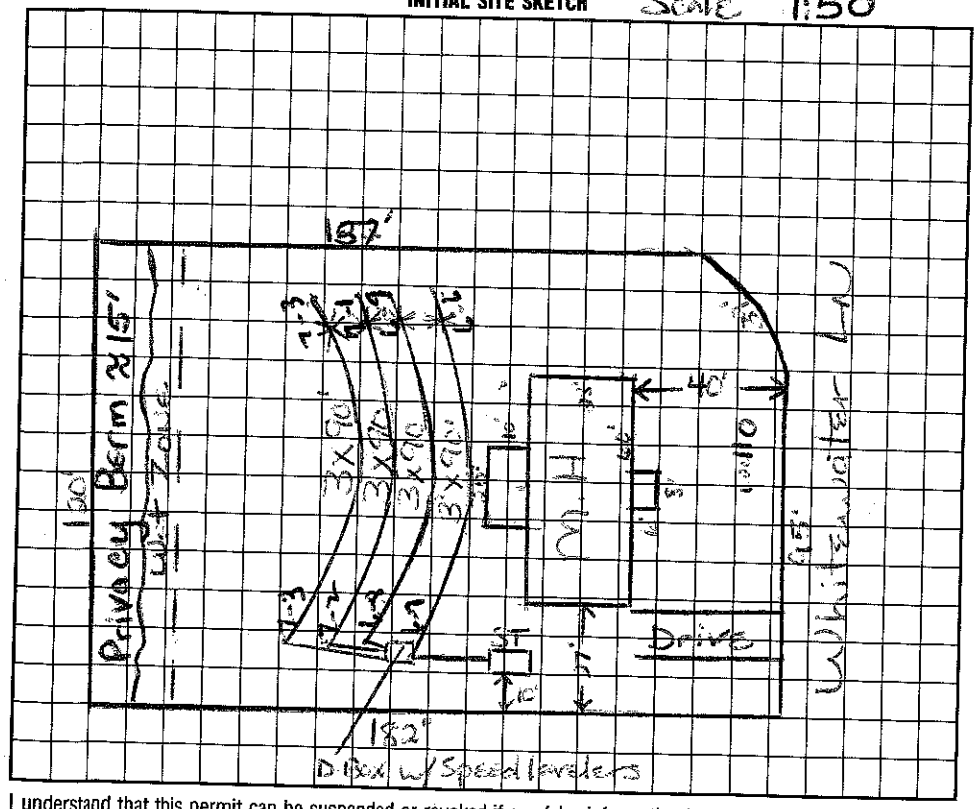

AS BUILT SKETCH

I understand that this permit can be suspended or revoked if any false information is supplied toward securing the permit/any unauthorized changes are made to the site/any unauthorized changes are made in the installation of the system. Improvement Permit is valid for 60 months from date of issuance.

Signed: _____

Improvement Permit by: Maria H. Watson date 6/24/97

Existing System Inspection by: Maria H. Watson date 6/24/97

Const Auth

Installed by: A1 Backhoe Service

Certificate of Completion by: Wesley Sparks RS. date 4/2/98

Operation Permit by: Wesley Sparks RS date 4/9/98

HEALTH DEPT. COPY: WHITE INSPECTION COPY (FINAL): GREEN OWNER COPY (FINAL): YELLOW INSPECTION COPY (INITIAL): PINK OWNER COPY (INITIAL): GOLD