(9:30) = Lot #4 Also Auth to 4659078319 9:30

IREDELL COUNTY HEALTH DEPARTMENT

Construct STATESVILLE 704-878-5305 MOORESVILLE 704-664-5281

IMPROVEMENT PERMIT / CERTIFICATE OF COMPLETION / OPERATION PERMIT / EXISTING SYSTEM INSPECTION

PROPERTY DESCRIPTION NO. 24859 DATE 6/19/97 TAX MAP NO. 4E A 12 Watershed: [X] Yes [ ] No

OWNER OR CONTRACTOR Pruitt Dev. Co. PHONE: Business _____ Home _____

ADDRESS 142 Stutts Rd. Mooresville NC

LOCATION 21 N. TL Sailwinds on Rt.

SUBDIVISION Landward Pt. BLOCK / SECTION 3rd LOT 10 LOT AREA 120' X 175' SITE CLASS. PS DESIGN FLOW 360 gpd L.T.A.R. .3

Septic Tank: 1000 Gallons; STB 794 Date 5/9/97

Pump Tank: _____ Gallons; PT _____ Date _____

Pump Make: _____ Model _____ Serial No. _____

Nitrification Field: No Fields ____ Square Feet _____ Linear Feet _____

No Lines 4 at 75' Trench Width 36" Max Trench Bottom Depth 36" Gravel Depth N/A

[X] New System [ ] Repair System Type: I, II, (III), IV, V, VI

System Description: Gravity-Plastic Chamber

Repair System Description: Mod. Fieldline

Maintenance Agreement Required: [ ] Yes [ ] No

[ ] House/Mod. Home No. Bedrooms 3

[X] Mobile Home No. Bathrooms 2

[ ] Business No. Employees ____

[ ] Other _____


[ ] Slab [X] Crawl Space [ ] Basement w/plumbing [ ] Basement wo/plumbing

Water Supply: [X] Individual [ ] Community [ ] Public

Comments: Keep lines at least 15' from S.I.t pond.
* Install inspection ports at end of each lateral.

Comments:

INITIAL SITE SKETCH Scale 1:50

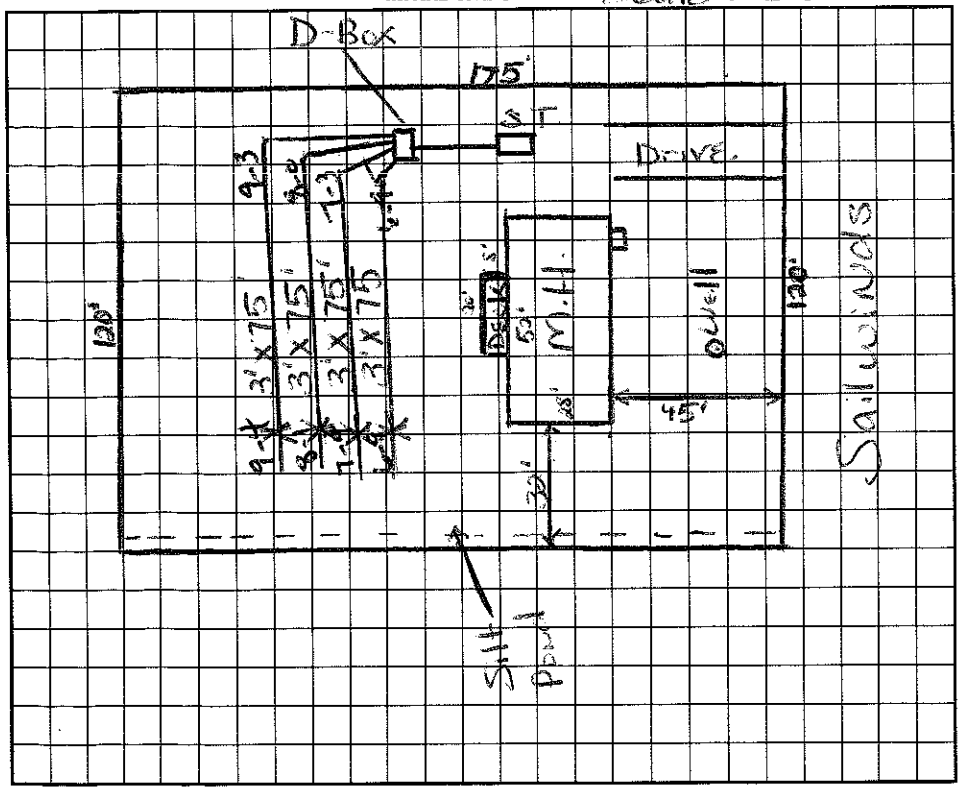

AS BUILT SKETCH

I understand that this permit can be suspended or revoked if any false information is supplied toward securing the permit/any unauthorized changes are made to the site/any unauthorized changes are made in the installation of the system. Improvement Permit is valid for 60 months from date of issuance.

Signed: _____

Improvement Permit by: Marion H. H. Latham date 6/19/97

Marion H. H. Latham date 6/19/97

Installed by: Atlantic Excavating

Certificate of Completion by: Wesley Sparks RS. date 8/27/97

Operation Permit by: Wesley Sparks RS date 8/27/97

OWNER COPY (FINAL): GREEN OWNER COPY (FINAL): YELLOW INSPECTION COPY (INITIAL): PINK OWNER COPY (INITIAL): GOLD