IREDELL COUNTY HEALTH DEPARTMENT

Auth to Construct 4659079431

STATESVILLE 704-878-5305 MOORESVILLE 704-664-5281

IMPROVEMENT PERMIT / ~~CERTIFICATE OF COMPLETION~~ / OPERATION PERMIT / EXISTING SYSTEM INSPECTION

PROPERTY DESCRIPTION NO. 24858 DATE 6/2/97 TAX MAP NO. 4EA12 Watershed: ☒ Yes ☐ No

OWNER OR CONTRACTOR Pruitt Dev. PHONE: Business (800) 722-3633 Home

ADDRESS 142 Stutts Rd

LOCATION US 115/21 N TL on Sailwinds on Right

SUBDIVISION Windward Pt BLOCK / SECTION LOT 9 LOT AREA 120'x175' SITE CLASS PS DESIGN FLOW 360gpd L.T.A.R. .3

Septic Tank: 1000 Gallons; STB 881 - Mull Date 6-30-97

Pump Tank: Gallons; PT Date

Pump Make: Model Serial No.

Nitrification Field: No Fields 1 Square Feet 900' Linear Feet 300'

No Lines 3 at 100' Trench Width 3' Max Trench Bottom Depth 36' Gravel Depth N/A

☒ New System ☐ Repair System Type: I, II, III, IV, V, VI

System Description: Plastic Chamber-Grav.

Repair System Description: Grav. Plastic Chamber

Maintenance Agreement Required: ☐ Yes ☒ No

☒ House/Mod. Home No. Bedrooms 3

☐ Mobile Home No. Bathrooms 2

☐ Business No. Employees

☐ Other


☐ Slab ☒ Crawl Space ☐ Basement w/plumbing ☐ Basement wo/plumbing

Water Supply: ☒ Individual ☐ Community ☐ Public


Comments: ☒ Install inspection ports near end of each line.

Comments:
7-29-97 Well not drilled; SWMH not on site
Installed substantially as on initial sketch

INITIAL SITE SKETCH 1:50

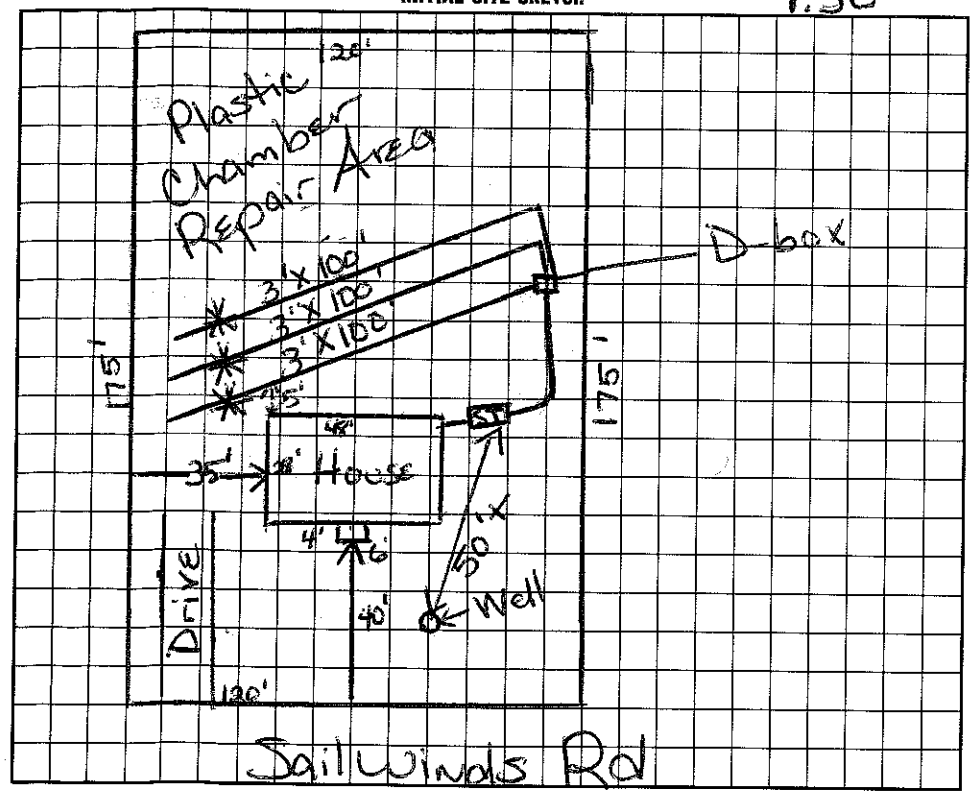

AS-BUILT SKETCH

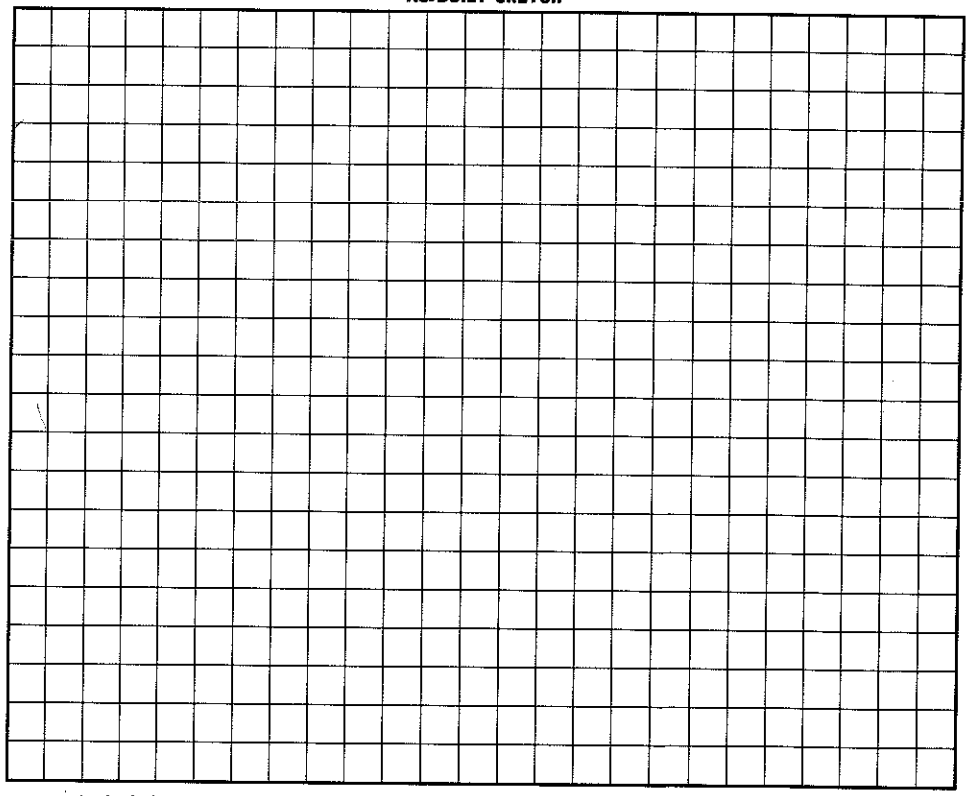

I understand that this permit can be suspended or revoked if any false information is supplied toward securing the permit/any unauthorized changes are made to the site/any unauthorized changes are made in the installation of the system. Improvement Permit is valid for 60 months from date of issuance.

Signed:

Improvement Permit by: Maria H. Dotson date 6/2/97

~~Existing System~~ Inspection by: Maria H. Dotson date 6/2/97

Auth. to Construct

Installed by: G&M

Certificate of Completion by: date

Operation Permit by: date 7-29-97

HEALTH DEPT. COPY: WHITE INSPECTION COPY (FINAL): GREEN OWNER COPY (FINAL): YELLOW INSPECTION COPY (INITIAL): PINK OWNER COPY (INITIAL): GOLD