IREDELL COUNTY HEALTH DEPARTMENT

Authorization to Construct

4659090235

STATESVILLE 704-878-5305 MOORESVILLE 704-664-5281

IMPROVEMENT PERMIT / ~~CERTIFICATE OF COMPLETION~~ / OPERATION PERMIT / EXISTING SYSTEM INSPECTION

PROPERTY DESCRIPTION NO. 22348 DATE 12/1/95 TAX MAP NO. 4F-B-129 Watershed: ☑ Yes ☐ No

OWNER OR CONTRACTOR Robert Oula PHONE: Business 704-528-0375 Home

ADDRESS 1250 old Charlotte Hwy Troutman NC 28166

LOCATION Hwy 21 North to Flowerhouse Loop - TL and go ≈500 yards - property on left

SUBDIVISION S.B.J Smith Little BLOCK / SECTION LOT 1 LOT AREA 3.75ac SITE CLASS. PS DESIGN FLOW 360 gpt L.T.A.R. .3 gpd/ft²

Septic Tank: 1000 Gallons; STB 794 Date 4/29/96

Pump Tank: Gallons; PT Date

Pump Make: Model Serial No.

Nitrification Field: No Fields 1 Square Feet 1200 Linear Feet 400

No Lines 4 Trench Width 36" Max Trench Bottom Depth 36" Gravel Depth 12"

☑ New System ☐ Repair System Type: I, ☑ II, III, IV, V, VI

System Description: Gravity Conventional

Repair System Description: Gravity Conventional

Maintenance Agreement Required: ☐ Yes ☑ No

☑ House/Mod. Home No. Bedrooms 3

☐ Mobile Home No. Bathrooms 2

☐ Business No. Employees

☐ Other

☐ Slab ☑ Crawl Space ☐ Basement w/plumbing ☐ Basement wo/plumbing


Water Supply: ☑ Individual ☐ Community ☐ Public

Comments:

Comments:

installed as drawn

INITIAL SITE SKETCH

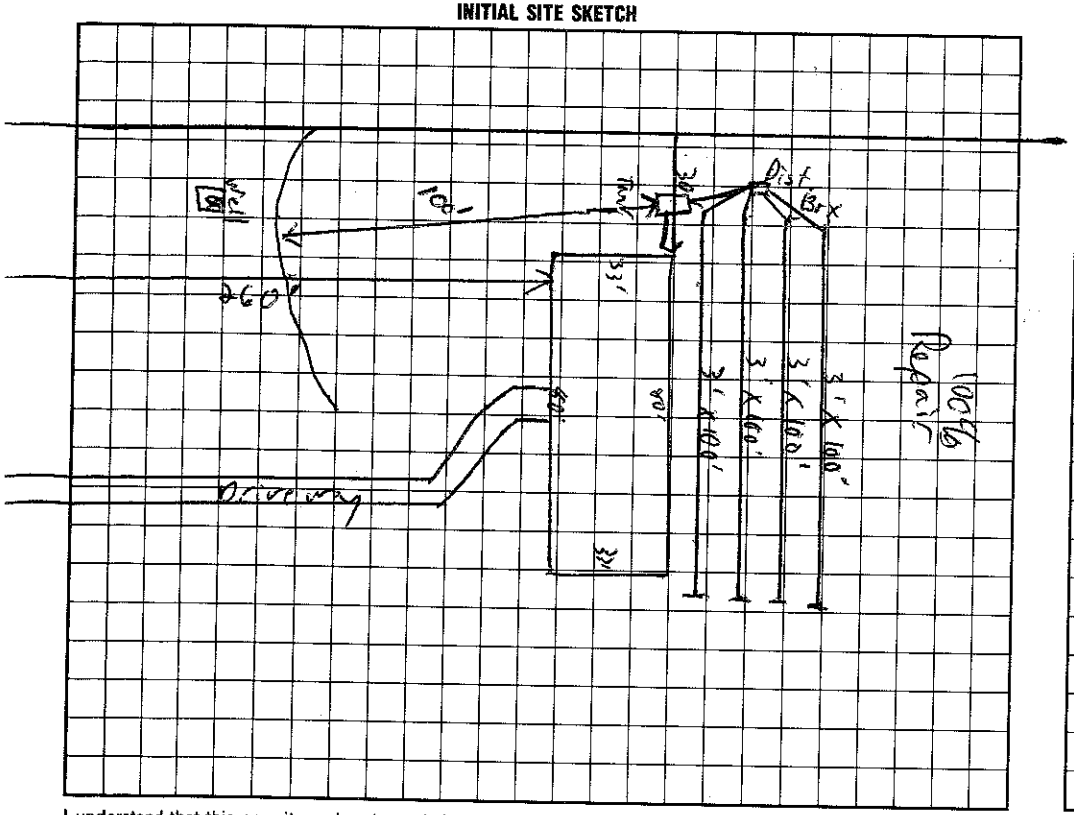

AS BUILT SKETCH

I understand that this permit can be suspended or revoked if any false information is supplied toward securing the permit/any unauthorized changes are made to the site/any unauthorized changes are made in the installation of the system.

Signed: Billy Stitt

Improvement Permit by: Wesley Sparks RS. date 12/1/95

~~Construct~~/Existing System Inspection by: ~~Construct~~/Wesley Sparks RS date 12/1/95

Installed by: Orbison Const Co.

Certificate of Completion by: date

Operation Permit by: Wesley Sparks RS. date 7/11/96

HEALTH DEPT. COPY: WHITE INSPECTION COPY (FINAL): GREEN OWNER COPY (FINAL): YELLOW INSPECTION COPY (INITIAL): PINK OWNER COPY (INITIAL): GOLD