IREDELL COUNTY HEALTH DEPARTMENT

Auth. to Construct

STATESVILLE 704-878-5305 MOORESVILLE 704-664-5281

IMPROVEMENT PERMIT / CERTIFICATE OF COMPLETION / OPERATION PERMIT / EXISTING SYSTEM INSPECTION

9:30

PROPERTY DESCRIPTION NO. 066976 DATE 6-17-97 TAX MAP NO. 4659092345

OWNER OR CONTRACTOR Robert Little PHONE: Business Home (704) 528-0629

ADDRESS P.O. Box 1236 Troutman, NC 28166

LOCATION US 21 N TR Flowerhouse Loop 2nd lot on left Watershed: ☐ Yes ☐ No

SUBDIVISION BLOCK / SECTION LOT LOT AREA 3.07 Acres SITE CLASS. P.S.

Septic Tank: 1000 Gallons; STB 714 Date 4/1/98

Pump Tank: Gallons; PT Date

Pump Make: Model Serial No.

Nitrification Field: No Fields 1 Square Feet 1200 Linear Feet 395-400'

No Lines 4 Trench Width 36" Max Trench Bottom Depth 30 Gravel Depth

☒ New System ☐ Repair System Type: I, (II), III, IV, V, VI

System Description: Gravity - Conventional

Repair System Description: Grav. Shallow Conv.

Maintenance Agreement Required: ☐ Yes ☒ No

☐ Slab ☐ Crawl Space ☐ Basement w/plumbing ☒ Basement wo/plumbing

DESIGN FLOW 360 gpd L.T.A.R. .3

☒ House/Mod. Home ☐ Mobile Home ☐ Business ☐ Other


No. Bedrooms 3 No. Bathrooms 2.5 No. Employees

Water: ☒ Individual ☐ Community ☐ Public


Comments: Feather off Old Farm Berms
Keep well (W) 100' from Septic System
Keep drain lines 15' from basement & Suppy lines 10' from basement

Comments:

INITIAL SITE SKETCH Scale 1:100

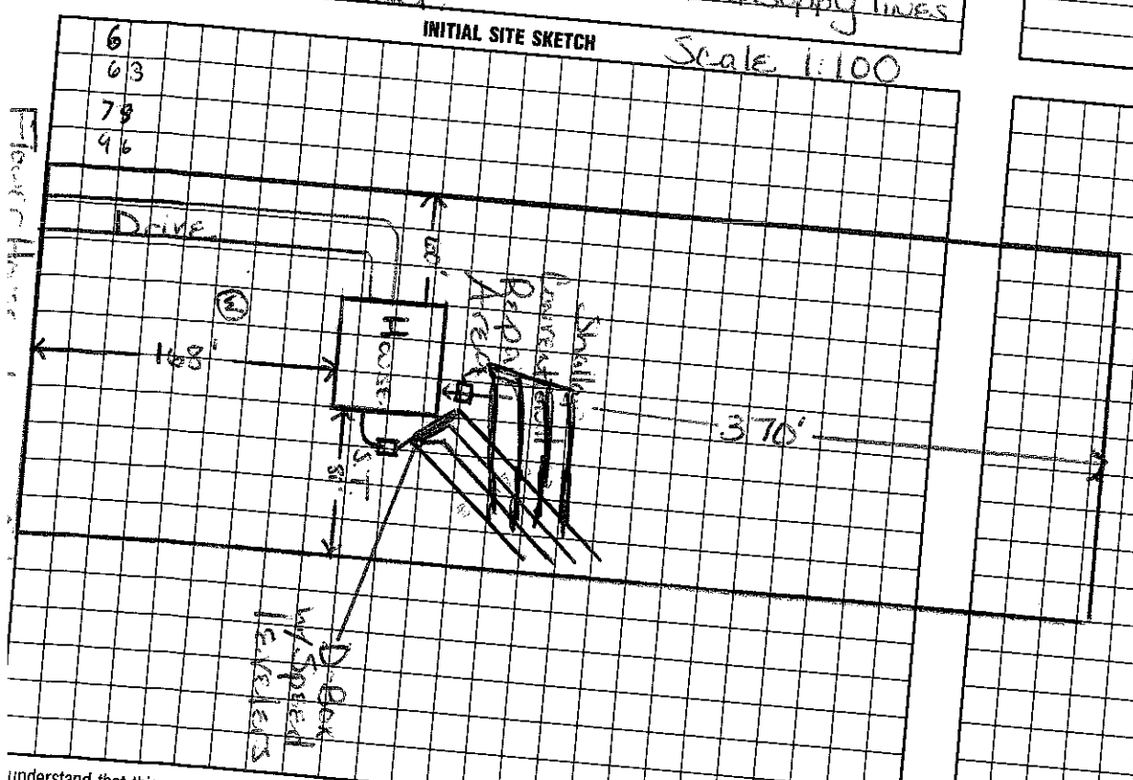

AS BUILT SKETCH

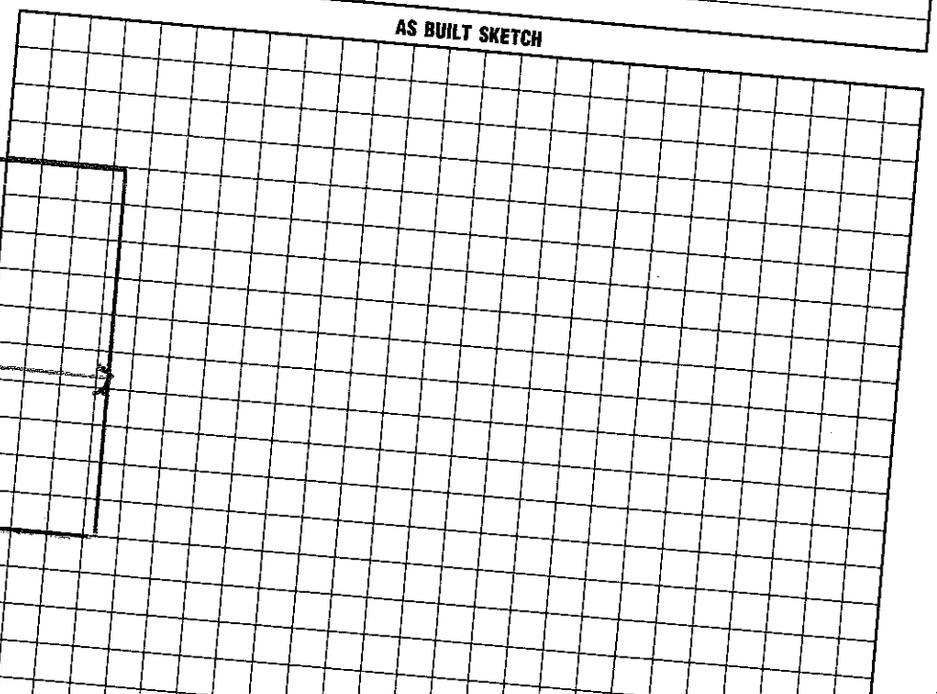

I understand that this permit can be suspended or revoked if any false information is supplied toward securing the permit/any unauthorized changes are made to the site/any unauthorized changes are made in the installation of the system. Improvement Permit is valid for 60 months from date of issuance.

Signed: X Bill Little

Improvement Permit by: Maria H.H. Dotson date 6/17/97

~~Existing System Inspection by:~~ Maria H.H. Dotson date 6/17/97

Auth. to Construct

Installed by: ORBISON

Certificate of Completion by: C. Ryan Ross RS date 6/17/98

Operation Permit by: date

HEALTH DEPT. COPY: WHITE INSPECTION COPY (FINAL): GREEN OWNER COPY (FINAL): YELLOW INSPECTION COPY (INITIAL): PINK OWNER COPY (INITIAL): GOLD