IREDELL COUNTY HEALTH DEPARTMENT

STATESVILLE 704-878-5305 MOORESVILLE 704-664-5281

IMPROVEMENT PERMIT / AUTHORIZATION TO CONSTRUCT / OPERATION PERMIT / EXISTING SYSTEM INSPECTION

PERMIT# 086937 PIN# 4659096595 DATE 3/29/2000

OWNER OR CONTRACTOR Carrie Smith PHONE: Business Home 528-4959

ADDRESS 1250 Charlotte Hwy Troutman, NC 28166

LOCATION Hwy 115/21 N TL at Flower house ON left

SUBDIVISION BLOCK / SECTION LOT LOT AREA 9.82 acre SITE CLASS. DESIGN FLOW 360 L.T.A.R.

Septic Tank: Existing Gallons; STB Date

Pump Tank: Gallons; PT Date

Pump Make: Model Serial No.

Nitrification Field: No Fields Existing Square Feet Linear Feet

No Lines Trench Width Max Trench Bottom Depth Gravel Depth

☐ New System ☐ Repair System Type: I, II, III, IV, V, VI

System Description: Existing Gravity Conventional

Repair System Description:

Maintenance Agreement Required: ☐ Yes ☒ No

☐ House/Mod. Home No. Bedrooms 2*

☒ Mobile Home No. Bathrooms 2

☐ Business No. Employees

☐ Other


☐ Slab ☐ Crawl Space ☐ Basement w/plumbing ☐ Basement wo/plumbing

Water Supply: ☒ Individual ☐ Public ☐ Community

Comments:/Conditions: Existing Septic System appears to be functioning okay at time of inspection, No problems noticed. Over 100' between MH & Existing Septic tank.

Comments:/Conditions: * Septic System previously approved for 3 Bedrooms Original Septic System repaired in 1976.

INITIAL SITE SKETCH Not to Scale

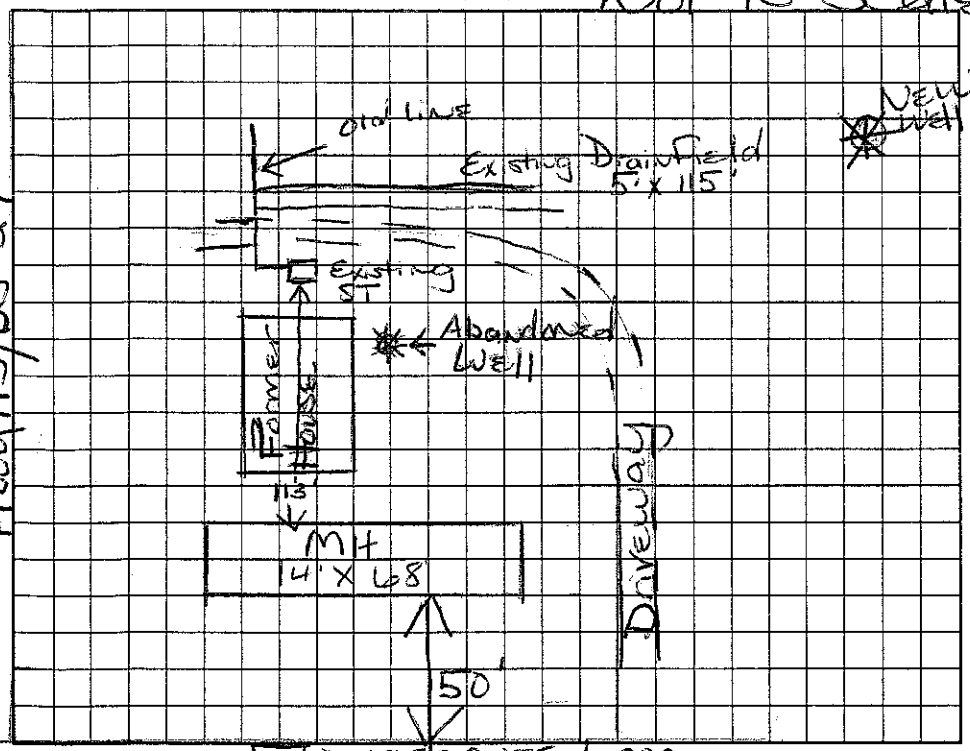

AS BUILT SKETCH

Permit can be suspended or revoked if any false information is supplied toward securing the permit/any unauthorized changes are made to the site/any unauthorized changes are made in the installation of the system. Improvement Permit with plat valid without expiration. Improvement Permit with site plan valid for sixty months. Authorization to Construct is valid for a period equal to that of Improvement Permit – not to exceed sixty months.

Signed: [signature] date Installed by:

Improvement Permit by: Mainard H. Dotson RS date 3/29/2000 Operation Permit by: date

Authorization to Construct by: date Existing System Inspection by Mainard H. Dotson RS date 3/29/2000

HEALTH DEPT. COPY: WHITE OWNER COPY (FINAL): YELLOW OWNER COPY (INITIAL): PINK