IREDELL COUNTY HEALTH DEPARTMENT

STATESVILLE 704-878-5305 MOORESVILLE 704-66

IMPROVEMENT PERMIT / AUTHORIZATION TO CONSTRUCT / OPERATION PERMIT / EXISTING SYSTEM INSPECTION

PERMIT# Repair PIN# Repair 4659 11 7487 DATE 12/29/99

OWNER OR CONTRACTOR Danny Russ PHONE: Business Home 664-1697

ADDRESS 239 Barfield Mooresville, NC

LOCATION Hwy 115/US 21 N TL Barfield approx 1/4 to 1/2 Mile on left

SUBDIVISION BLOCK / SECTION LOT LOT AREA Acreage SITE CLASS. PS DESIGN FLOW L.T.A.R. .3

Wash Box

Septic Tank: 75 gal Gallons; STB Date

Pump Tank: Gallons; PT Date

Pump Make: Model Serial No.

Nitrification Field: No Fields Square Feet 300' Linear Feet 100'

No Lines 2 at 50' Trench Width 36" Max Trench Bottom Depth 36" Gravel Depth 12"

☐ New System ☒ Repair System Type: I, II, III, IV, V, VI

System Description: Gravity - Conventional

Repair System Description:

Maintenance Agreement Required: ☐ Yes ☒ No

☒ House/Mod. Home No. Bedrooms

☐ Mobile Home No. Bathrooms

☐ Business No. Employees

☐ Other


☐ Slab ☐ Crawl Space ☐ Basement w/plumbing ☐ Basement wo/plumbing

Water Supply: ☐ Individual ☐ Public ☐ Community


Comments/Conditions: Install 75 gallon Washer box & 2 - 3'X 50' Drainlines. Must keep 50' from Existing well

Comments/Conditions: Note: Check D-Box of Existing Septic System for proper Distribution ~~Filter installed~~ Original Septic System installed 10-13-89.

INITIAL SITE SKETCH

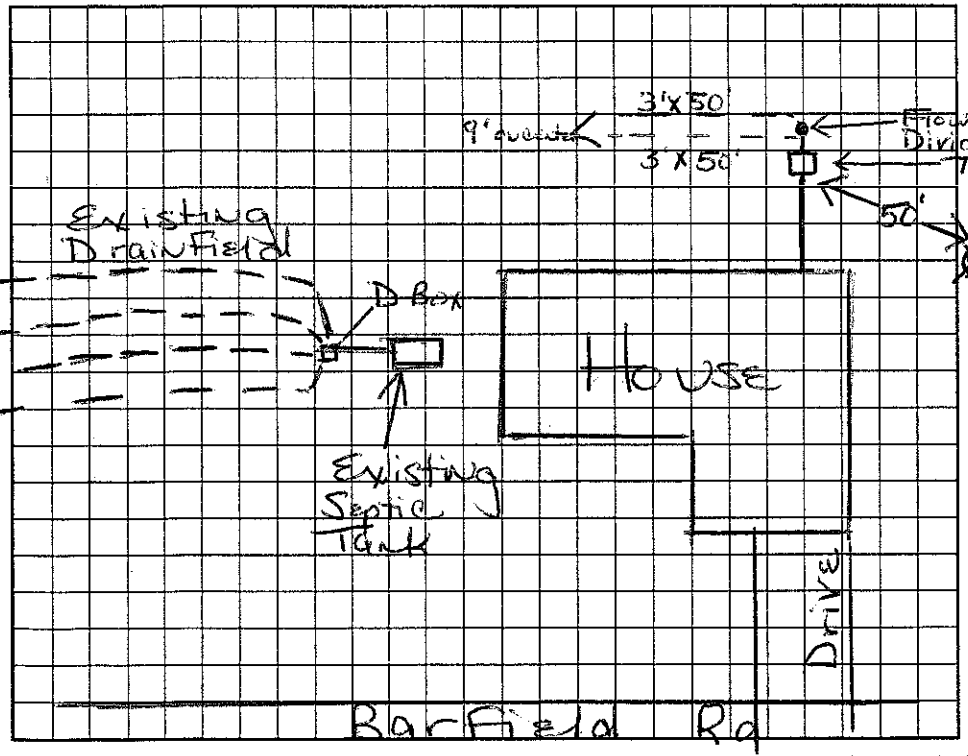

AS BUILT SKETCH

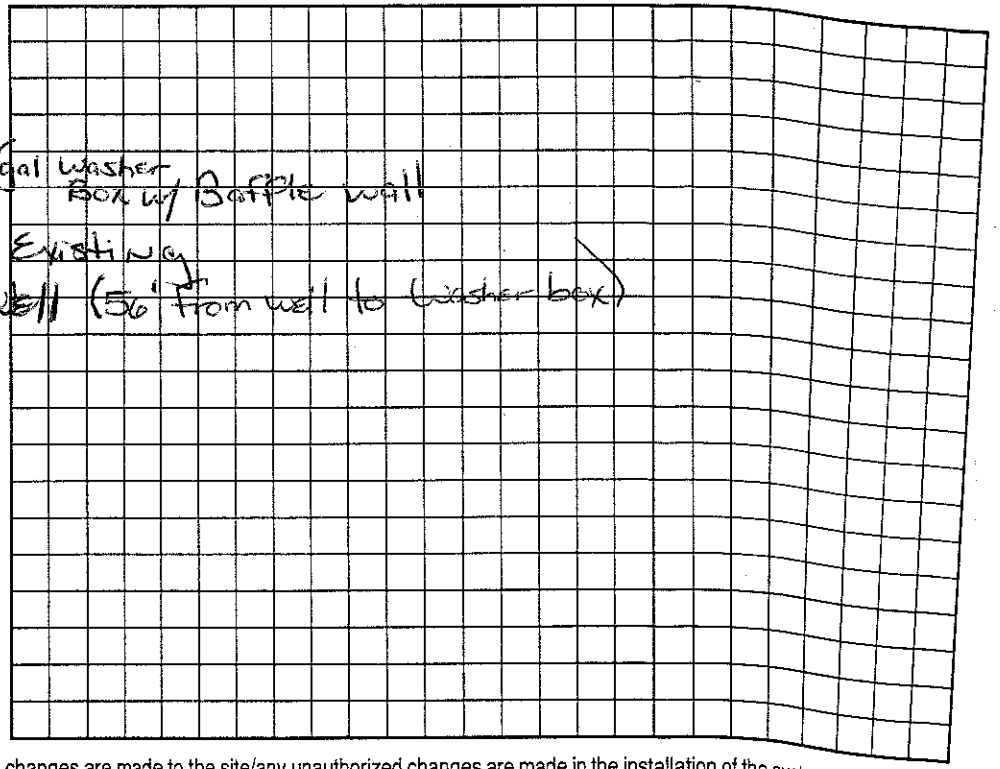

Permit can be suspended or revoked if any false information is supplied toward securing the permit/any unauthorized changes are made to the site/any unauthorized changes are made in the installation of the system. Improvement Permit with plat valid without expiration. Improvement Permit with site plan valid for sixty months. Authorization to Construct is valid for a period equal to that of Improvement Permit – not to exceed sixty months.

Signed: date 1-3-00 Installed by: FJ Ervin

Improvement Permit by: Maria Dotson RS. date 12/29/99 Operation Permit by: Maria Dotson RS. date 5/15/2000

Authorization to Construct by: Maria Dotson RS. date 12/29/99 Existing System Inspection by: date

HEALTH DEPT. COPY: WHITE OWNER COPY (FINAL): YELLOW OWNER COPY (INITIAL): PINK