IREDELL COUNTY HEALTH DEPARTMENT

STATESVILLE 704-878-5305 MOORESVILLE 704-664-5281

IMPROVEMENT PERMIT / AUTHORIZATION TO CONSTRUCT / OPERATION PERMIT / EXISTING SYSTEM INSPECTION

PERMIT # 160326 PIN # 4659-13-5619 4659134784 DATE 3-25-10

OWNER or APPLICANT ROBERT REID PHONE: Business 704-253-3478 Home:

OWNER or APPLICANT ADDRESS 185 PARKERTOWN RD

LOCATION / DIRECTIONS ZIN, TL PARKERTOWN, TL MARCUS C END

SUBDIVISION BLOCK / SECTION LOT # PT-3 LOT AREA DESIGN FLOW 240 GPD L.T.A.R. .3

Septic Tank 1000 Gallons: STB 160 Date 10-26-09

Pump Tank Gallons: P T Date

Pump Make Model Serial #

Nitrification Field No Fields 1 No Lines 3 Linear Feet ~~240~~ 210'

Trench Width 36" Max. Trench Bottom Depth 36" Gravel Depth 12"

☒ New System ☐ Repair ☐ Expansion System Type I (II) III IV V VI

System Description: ~~GRAVITY GRAVEL~~ 25%

Repair System Description: SAME

Maintenance Agreement Required ☐ YES ☒ NO

☒ GRAVITY ☐ PRESSURE

☒ Residence No. Bedrooms 2

☐ Business No. Persons

☐ Other No. Employees

☐ Slab ☒ Crawl Space


☐ Basement w/plumbing ☐ Basement w/o plumbing

Water Supply: ☒ Private ☐ Public ☐ Community


Comments / Conditions 1) MEET ALL REQUIRED SETBACKS 2) DRAIN LINES & DROX MUST BE 10' OFF PROPERTY LINE 3) SEPTIC MUST BE 100' FROM WELL

Comments / Conditions

INITIAL SITE SKETCH

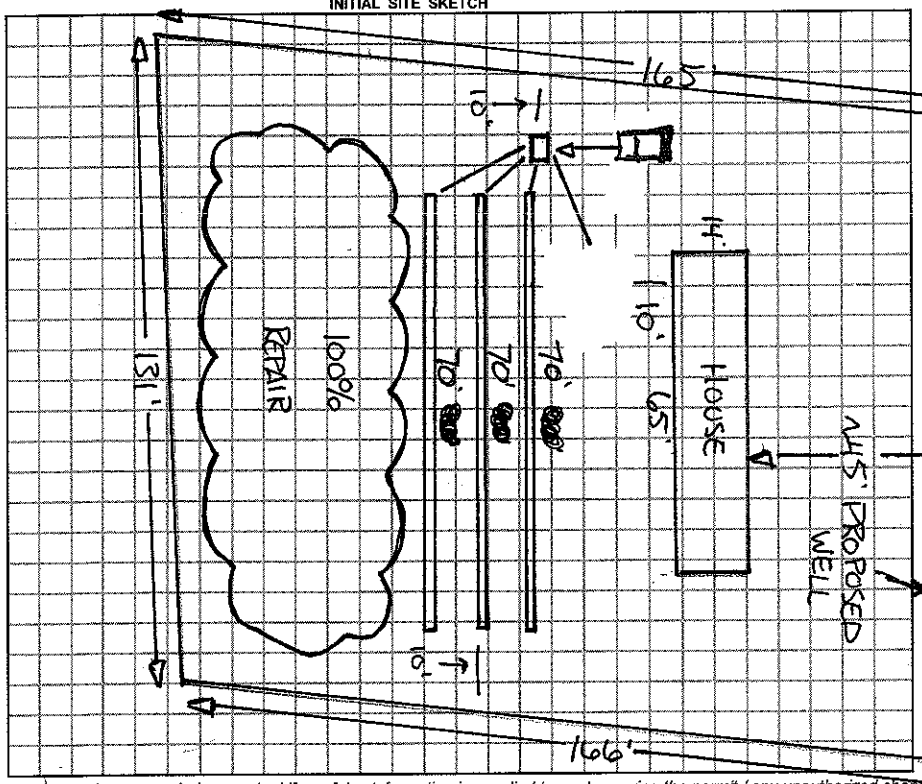

AS BUILT SKETCH

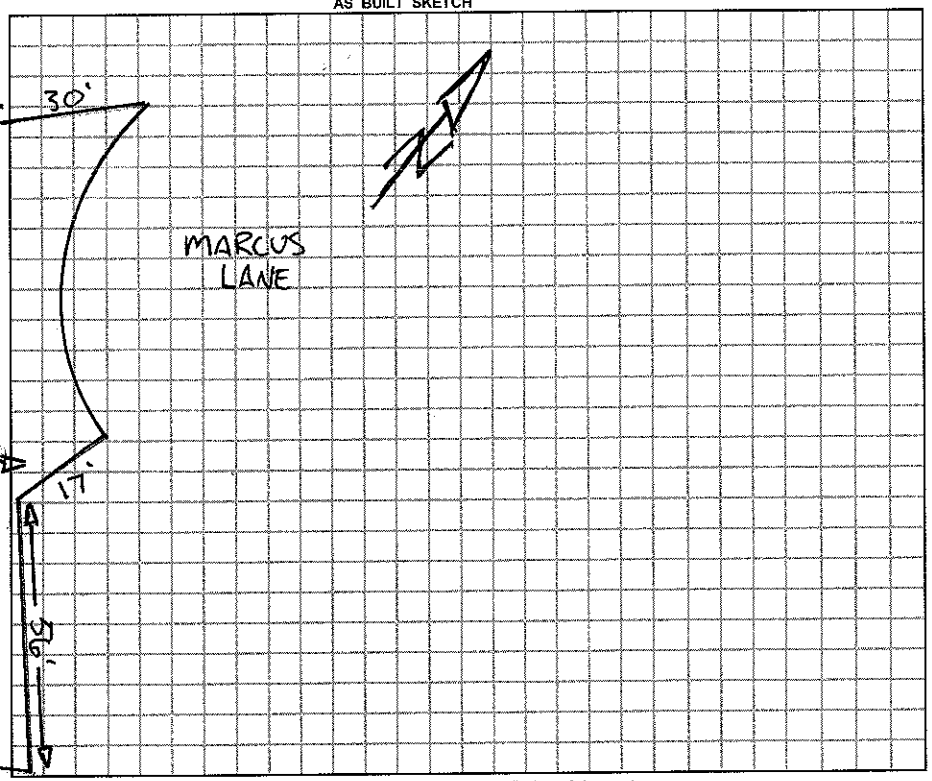

Permit can be suspended or revoked if any false information is supplied toward securing the permit / any unauthorized changes are made to the site / any unauthorized changes are made in the installation of the system.

☐ *IMPROVEMENT PERMIT w / plot valid without expiration.* ☐ *IMPROVEMENT PERMIT w / site plan valid for 60 mos.* ☒ *AUTHORIZATION TO CONSTRUCT valid for period equal to IMPROVEMENT PERMIT-not to exceed 60 mo.*

Owner / Applicant Signature: Robert Reid Date 3-26-10

Improvement Permit by: R. A. Reid REHS Date 3-25-10

Authorzation to Construct by: R. A. Reid REHS Date 3-25-10

YOU SHOULD CONTACT A LOCATOR SERVICE PRIOR TO ANY EXCAVATION.

Installed by: BARNES BACKHOE

Operation Permit by: R. A. Reid REHS Date:

Existing System Inspected by: Date: 4-21-10

WHITE COPY Environmental Health YELLOW COPY (Final) Owner / Applicant PINK COPY (Initial) Owner / Applicant