IREDELL COUNTY HEALTH DEPARTMENT

STATESVILLE 704-878-5305 130.00 Fee MOORESVILLE 704-664-5281

IMPROVEMENT PERMIT / AUTHORIZATION TO CONSTRUCT / OPERATION PERMIT / EXISTING SYSTEM INSPECTION

PERMIT# 109349 PIN# ~~4659 13 4883.8~~ 4659134812 DATE 4/15/03

OWNER OR CONTRACTOR David J Stevenson PHONE: Business 704-878-0283 Home

ADDRESS 520 Fayetteville Rd Statesville NC 28677

LOCATION 115 N TL Parkertown Rd. TL Clarkton Drive to 3RD lot on (R) 124 Clarkton Rd.

SUBDIVISION Stevenson BLOCK / SECTION LOT 8 LOT AREA ~.5Ac SITE CLASS. PS DESIGN FLOW 360 L.T.A.R. .3

Septic Tank: 1000 Gallons; STB 1007 Date 7/11/03
Pump Tank: Gallons; PT Date
Pump Make: Model Serial No.
Nitrification Field: No Fields 1 Square Feet 900± Linear Feet 300±
No Lines 3@100 Trench Width 3' Max Trench Bottom Depth 3'

[X] New System ☐ Repair System Type: I, II, (III) IV, V, VI
System Description: * 25% Reduced Drainfield
Repair System Description: Same
Maintenance Agreement Required: ☐ Yes [X] No

[X] House/Mod. Home No. Bedrooms 3
☐ Mobile Home No. Bathrooms 3
☐ Business No. Employees
☐ Other


Water Supply: ☐ Individual ☐ Public [X] Community ON LOT 6

Gravel Depth N/A ☐ Slab [X] Crawl Space ☐ Basement w/plumbing ☐ Basement wo/plumbing

Comments:/Conditions:


(1" = 50')

INITIAL SITE SKETCH

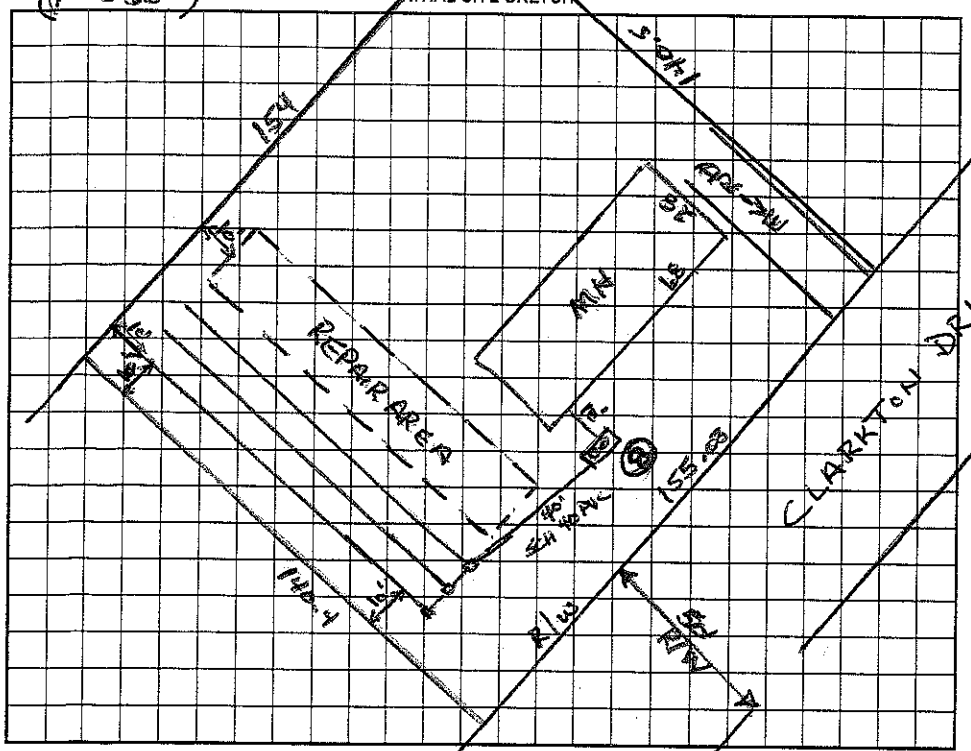

Comments:/Conditions:

AS BUILT SKETCH

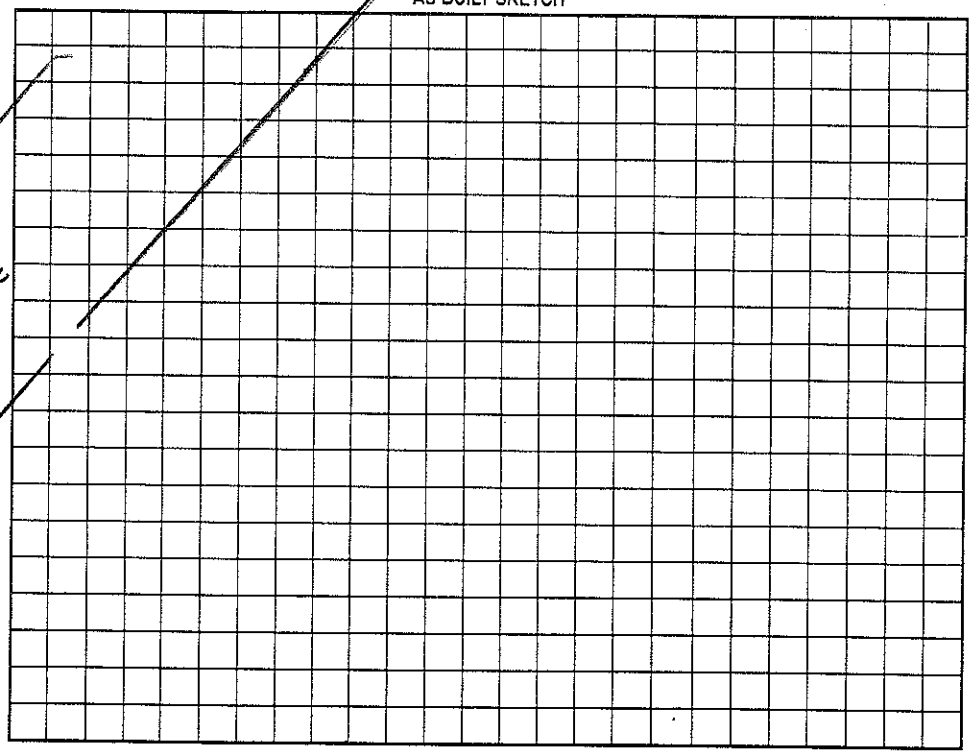

Permit can be suspended or revoked if any false information is supplied toward securing the permit/any unauthorized changes are made to the site/any unauthorized changes are made in the installation of the system. Improvement Permit with plat valid without expiration. Improvement Permit with site plan valid for sixty months. Authorization to Construct is valid for a period equal to that of Improvement Permit – not to exceed sixty months.

Signed: * David Stevenson date 4/25/03

Improvement Permit by: Wesley Sparks RS. date 4/15/03

Authorization to Construct by: Wesley Sparks RS. date 4/15/03

Installed by: Barnes Backhoe Svcs.

Operation Permit by: Wesley Sparks RS date 9/3/03

Existing System Inspection by: date

HEALTH DEPT. COPY: WHITE OWNER COPY (FINAL): YELLOW OWNER COPY (INITIAL): PINK