IREDELL COUNTY HEALTH DEPARTMENT

STATESVILLE 704-878-5305 [redacted] 664-5281

Paid 175.00

IMPROVEMENT PERMIT / AUTHORIZATION TO CONSTRUCT / OPERATION PERMIT / EXISTING SYSTEM INSPECTI

PERMIT# 688413 PIN# 4659 13 4787 Pt. 4659-13-4906 DATE 4/13/00

OWNER OR CONTRACTOR Phyllis Stevenson PHONE: Business _____ Home 878-2635

ADDRESS 520 Fayetteville Ave. Statesville, NC. 28677

LOCATION Parkertown Rd. TL on gravel before Armour Rd.

SUBDIVISION No BLOCK / SECTION _____ LOT _____ LOT AREA .5 SITE CLASS. PS DESIGN FLOW 480 L.T.A.R. .3

Septic Tank: 1000 Gallons; STB 1612 Date 1/18/00
Pump Tank: _____ Gallons; PT _____ Date _____
Pump Make: _____ Model _____ Serial No. _____
Nitrification Field: No Fields 1 Square Feet 1200 Linear Feet 400
No Lines 5@80'&3' Trench Width 36" Max Trench Bottom Depth 36" ~~Gravel Depth~~ SAND.

☒ New System ☐ Repair System Type: I, II, (III), IV, V, VI
System Description: GRAV - CH PLASTIC
Repair System Description: 16" PPBS
Maintenance Agreement Required: ☐ Yes ☒ No

☒ House/Mod. Home No. Bedrooms 4
☐ Mobile Home No. Bathrooms 2
☐ Business No. Employees ____
☐ Other


Water Supply: ☒ Individual ☐ Public ☐ Community

☐ Slab ☒ Crawl Space ☐ Basement w/plumbing ☐ Basement wo/plumbing

Comments:/Conditions:

(1" = 50')

INITIAL SITE SKETCH

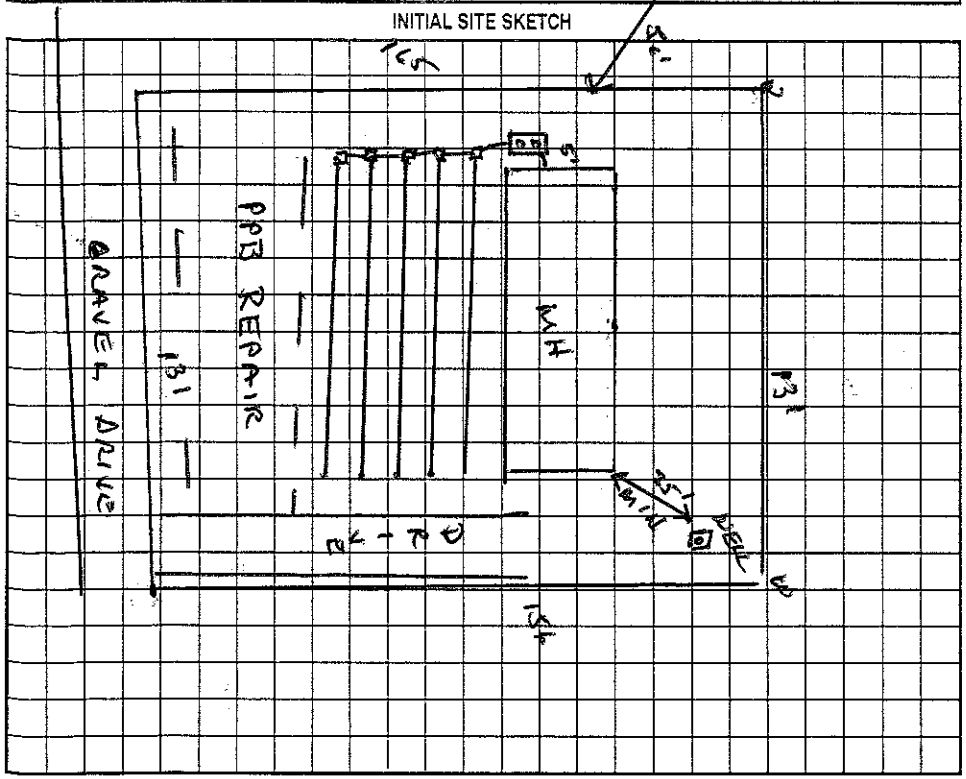

Comments:/Conditions:

AS BUILT SKETCH

Permit can be suspended or revoked if any false information is supplied toward securing the permit/any unauthorized changes are made to the site/any unauthorized changes are made in the installation of the system. Improvement Permit with plat valid without expiration. Improvement Permit with site plan valid for sixty months. Authorization to Construct is valid for a period equal to that of Improvement Permit – not to exceed sixty months.

Signed: * _____ date 4/14/00 Installed by: A-1 Backhoe

Improvement Permit by: Wesley Sparks RS. date 4/12/00 Operation Permit by: Wesley Sparks RS. date 4/20/00

Authorization to Construct by: Wesley Sparks RS. date 4/12/00 Existing System Inspection by: _____ date _____

HEALTH DEPT. COPY: WHITE OWNER COPY (FINAL): YELLOW OWNER COPY (INITIAL): PINK