IREDELL COUNTY HEALTH DEPARTMENT

STATESVILLE 704-878-5305 130.00 Paid MOORESVILLE 704-664-5281

IMPROVEMENT PERMIT / AUTHORIZATION TO CONSTRUCT / OPERATION PERMIT / EXISTING SYSTEM INSPECTION

PERMIT# 109348 PIN# ~~4659 13 7883.1~~ 4659138945 DATE 4/1/03

OWNER OR CONTRACTOR David J. Stevenson PHONE: Business Home 704-878-0283

ADDRESS 520 Fayetteville Rd. Statesville, NC. 28677 116 Clarkton Dr.

LOCATION 115N TL Parkertown Rd TL Clarkton Drive, 2nd lot on (R)

SUBDIVISION STEVENSON BLOCK / SECTION LOT 7 LOT AREA .5AC SITE CLASS. PS DESIGN FLOW 360 L.T.A.R. .3

Septic Tank: 1000 Gallons; STB 1067 Date 1/11/03
Pump Tank: Gallons; PT Date
Pump Make: Model Serial No.
Nitrification Field: No Fields 1 Square Feet 900 * Linear Feet 300 *
No Lines 3 @ 100' Trench Width 3' Max Trench Bottom Depth 3' Gravel Depth N/A

[X] New System [ ] Repair System Type: I, II, (III), IV, V, VI
System Description: GRAVITY - 25% REDUCED
Repair System Description: SAME TYPE
Maintenance Agreement Required: [ ] Yes [X] No
[ ] Slab [X] Crawl Space [ ] Basement w/plumbing [ ] Basement wo/plumbing

[ ] House/Mod. Home No. Bedrooms 3
[X] Mobile Home No. Bathrooms 2
[ ] Business No. Employees
[ ] Other


Water Supply: [ ] Individual [ ] Public [X] Community ON LOT 6 *

Comments:/Conditions: * WELL MUST BE LOCATED ON LOT 6 *
THIS IS 25% REDUCED DRAINFIELD


Comments:/Conditions:

(1" = 50')

INITIAL SITE SKETCH

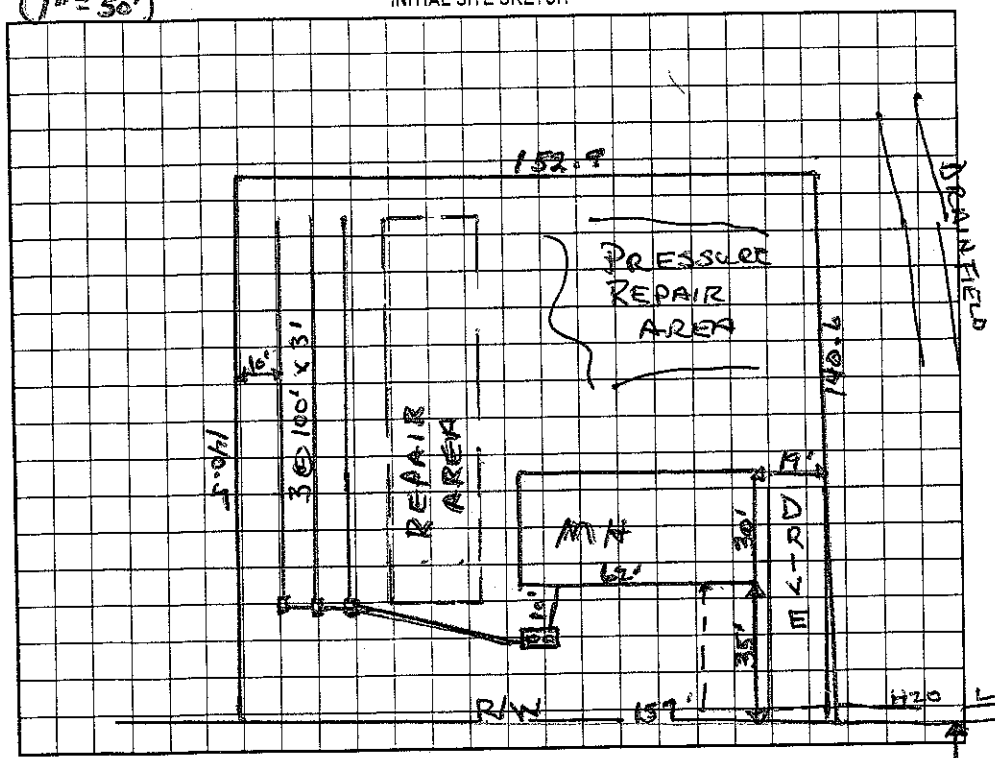

AS BUILT SKETCH

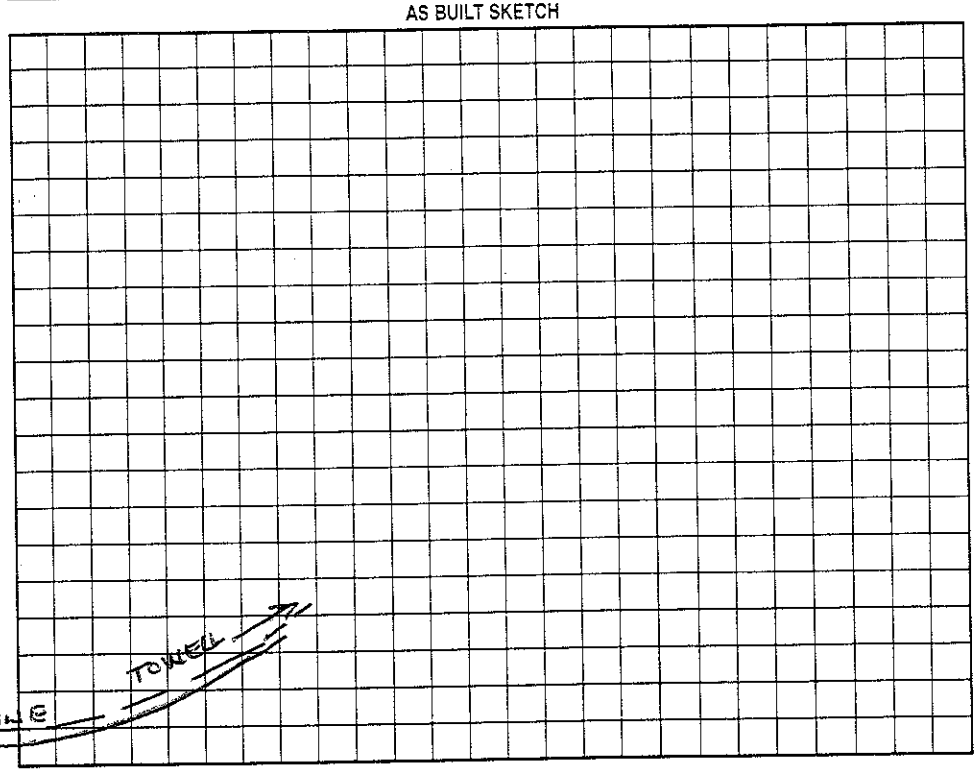

Permit can be suspended or revoked if any false information is supplied toward securing the permit/any unauthorized changes are made to the site/any unauthorized changes are made in the installation of the system. Improvement Permit with plat valid without expiration. Improvement Permit with site plan valid for sixty months. Authorization to Construct is valid for a period equal to that of Improvement Permit – not to exceed sixty months.

CLARKTON DRIVE

Signed: * David Stevenson date 4/25/03 Installed by: Burgess Backhoe Service

Improvement Permit by: Wesley Sparks RS. date 4/1/03 Operation Permit by: Wesley Sparks RS. date 9/2/03

Authorization to Construct by: Wesley Sparks RS date 4/1/03 Existing System Inspection by: date

HEALTH DEPT. COPY: WHITE OWNER COPY (FINAL): YELLOW OWNER COPY (INITIAL): PINK