IREDELL COUNTY HEALTH DEPARTMENT

STATESVILLE 704-878-5305 MOORESVILLE 704-664-5281

IMPROVEMENT PERMIT / AUTHORIZATION TO CONSTRUCT / OPERATION PERMIT / EXISTING SYSTEM INSPECTION

PERMIT# 147621 PIN# 4659149475 DATE 1-31-08

OWNER OR APPLICANT Freedom Homes - Troutman PHONE: Business 704-528-7960 Home

ADDRESS 1042 Charlotte Hwy Troutman NC 28166

LOCATION Hwy 21 N Tl Parkertown on right 162 Parkertown Rd

SUBDIVISION BLOCK / SECTION LOT LOT AREA .93 ac. SITE CLASS. PS DESIGN FLOW 360gpd L.T.A.R. .3gpd/ft²

Septic Tank: 1000 Gallons: STB 960 Date 10-19-07

Pump Tank: Gallons: PT Date

Pump Make: Model Serial No.

Nitrification Field: No Fields 1 Square Feet 900 Linear Feet 300

No Lines 5 Trench Width 36" Max Trench Bottom Depth 36"

☒ New System ☐ Repair ☐ Expansion System Type: I ◐ III IV V VI

System Description: 25% reduction gravity

Repair System Description: 25% reduction gravity

Maintenance Agreement Required: ☐ Yes ☒ No

☐ House/Mod. Home ☒ Mobile Home ☐ Business ☐ Other

No. Bedrooms 3 No. Persons 6 No. Employees


Water Supply: ☒ Individual ☐ Public ☐ Community

Gravel Depth NA ☒ Gravity ☐ Pressure ☐ Slab ☑ Crawl Space ☐ Basement w/plumbing ☐ Basement wo/plumbing

Comments/Conditions: Supply line and system must be at least 50' from any wells system must be 10'+ from property lines side property lines must be marked


1" = 60'

INITIAL SITE SKETCH

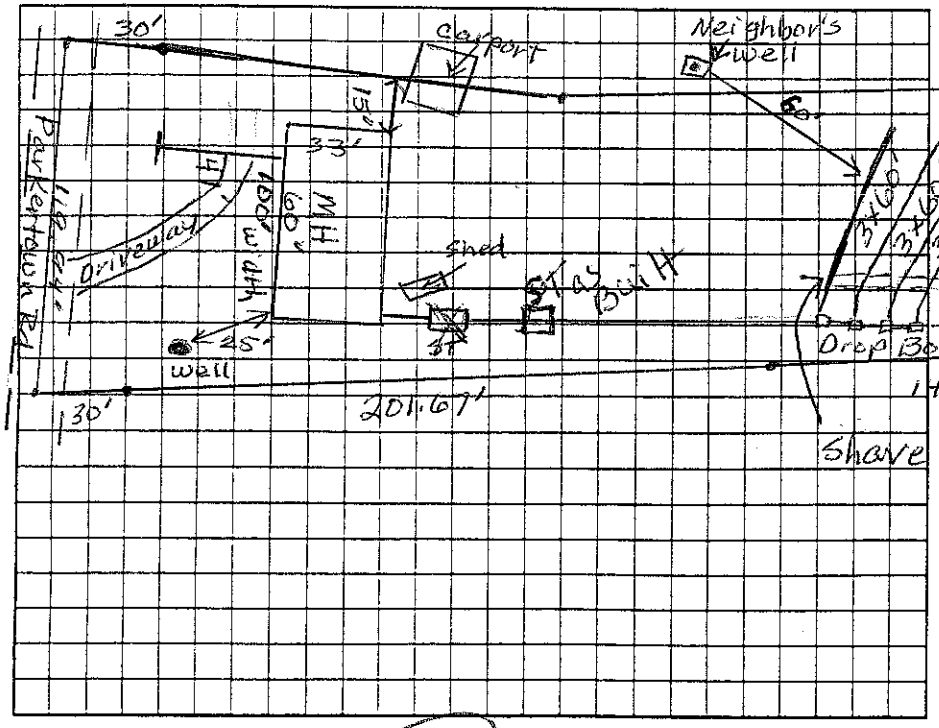

Comments/Conditions: Red polylok filter Quick 4 Std. Chamber, installed as per initial site sketch w/ End cap distribution

AS BUILT SKETCH

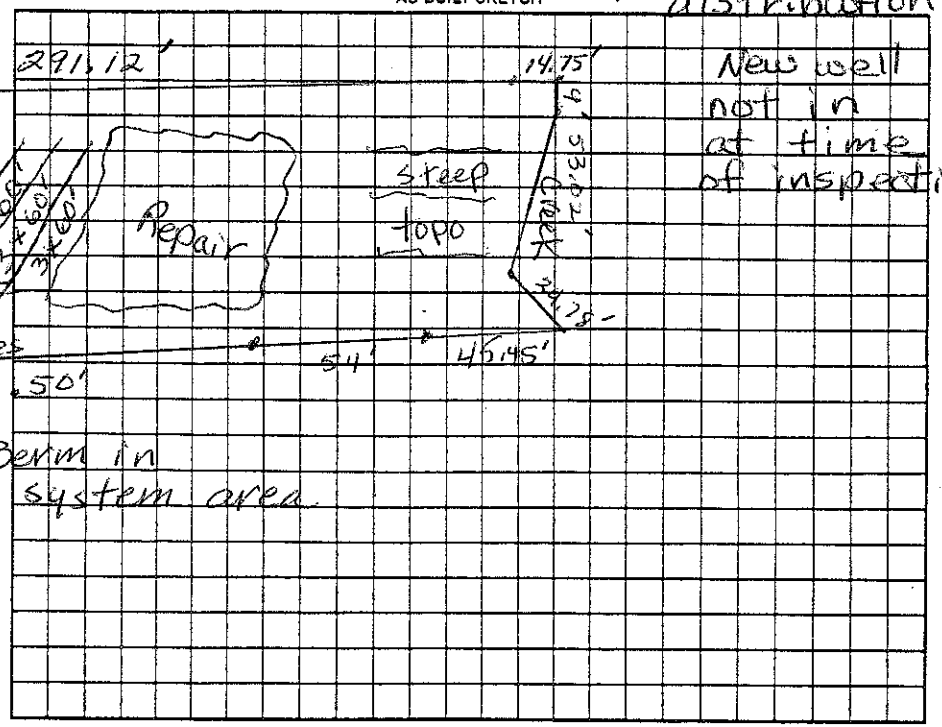

Shave Berm in system area.

Permit can be suspended or revoked if any false information is supplied toward securing the permit/any unauthorized changes are made to the site/any unauthorized changes are made in the installation of the system. Improvement Permit with plat valid without expiration ☐ Improvement Permit with site plan valid for sixty months ☒ Authorization to Construct is valid for a period equal to that of Improvement Permit – not to exceed sixty months.

Signed: date 2-2-08 Installed by: Abee's Grading Tim Abee

Improvement Permit by: Judy Melville date 1-31-08 Operation Permit by: Judy Melville date 2-2-08

Authorization to Construct by: Judy Melville date 1-31-08 Existing System Inspection by: date

HEALTH DEPT. COPY: WHITE OWNER COPY (FINAL): YELLOW OWNER COPY (INITIAL): PINK