Site Address: 120 Harvest Wind Ct, Mrsvl. 12:00

IREDELL COUNTY HEALTH DEPARTMENT

STATESVILLE 704-878-5305 MOORESVILLE 704-664-5281

IMPROVEMENT PERMIT / AUTHORIZATION TO CONSTRUCT / OPERATION PERMIT / EXISTING SYSTEM INSPECTION

PERMIT# 147328 217475 PIN# 4659153322.000 DATE 1/24/08

OWNER OR APPLICANT E&J Development Co. PHONE: Business 704 201-6465 Home

ADDRESS PO Box 1065 Huntersville, NC 28070

LOCATION Hwy 21 N TL Clear Spring TL Autumn Grove TR Early Frost TL Harvest Wind on right

SUBDIVISION Autumn Grove BLOCK / SECTION 2 LOT 34 LOT AREA .55ac SITE CLASS. PS DESIGN FLOW 360 L.T.A.R. .3

Septic Tank: 1000 Gallons; STB 760 Date 4/15/14

Pump Tank: 1000 Gallons; PT 319 Date 5/26/15

Pump Make: Model Serial No.

Nitrification Field: No Fields 1 Square Feet 450'/675 Linear Feet 225'

No Lines 4 Trench Width 36"/24" Max Trench Bottom Depth 36"

☑ New System ☐ Repair ☐ Expansion System Type: I II III (IV) V VI

System Description: LPP BPS

Repair System Description: Same

Maintenance Agreement Required: ☑ Yes ☐ No

☑ House/Mod. Home No. Bedrooms 3

☐ Mobile Home No. Persons

☐ Business No. Employees

☐ Other

Water Supply: ☑ Individual ☐ Public ☐ Community

Gravel Depth N/A ☐ Gravity ☑ Pressure ☐ Slab ☑ Crawl Space ☐ Basement w/plumbing ☐ Basement wo/plumbing

Comments:/Conditions:

INITIAL SITE SKETCH

See Plans by Rollins Soil & Env. Services, Inc

Comments:/Conditions: Tanks Location Changed To Accommodate House Location For AC. I Will Permit. Changed Approved By Rollins Soil & Environ. Services. (See Attached.) Keep Tanks 10' From Building Foundation.

AS BUILT SKETCH

	Date	Initials
Drain Lines Checked	8/19/16	AWS
Tanks Checked	8/18/16	AWS
Pressure Manifold or Valve Box Checked	8/19/16	AWS
Pressure Head Set	9/14	WS
Electrical Checked	9/14	WS
Floats Set	9/14	WS
Alarm Checked	9/14	WS
Maintenance Contract Y / N		
Comments:		


Permit can be suspended or revoked if any false information is supplied toward securing the permit/any unauthorized changes are made to the site/any unauthorized changes are made in the installation of the system. Improvement Permit with plat valid without expiration ☐ Improvement Permit with site plan valid for sixty months ☑ Authorization to Construct is valid for a period equal to that of Improvement Permit – not to exceed sixty months.

Signed: date 2-19-08 Installed by: Water Management INC

Improvement Permit by: Anthony Cohen Jr date 1/24/08 Operation Permit by: date 9-21-16

Authorization to Construct by: APPROVED APR 18 2016 Existing System Inspection by: date

HEALTH DEPT. COPY: WHITE OWNER COPY (FINAL): YELLOW OWNER COPY (INITIAL): PINK

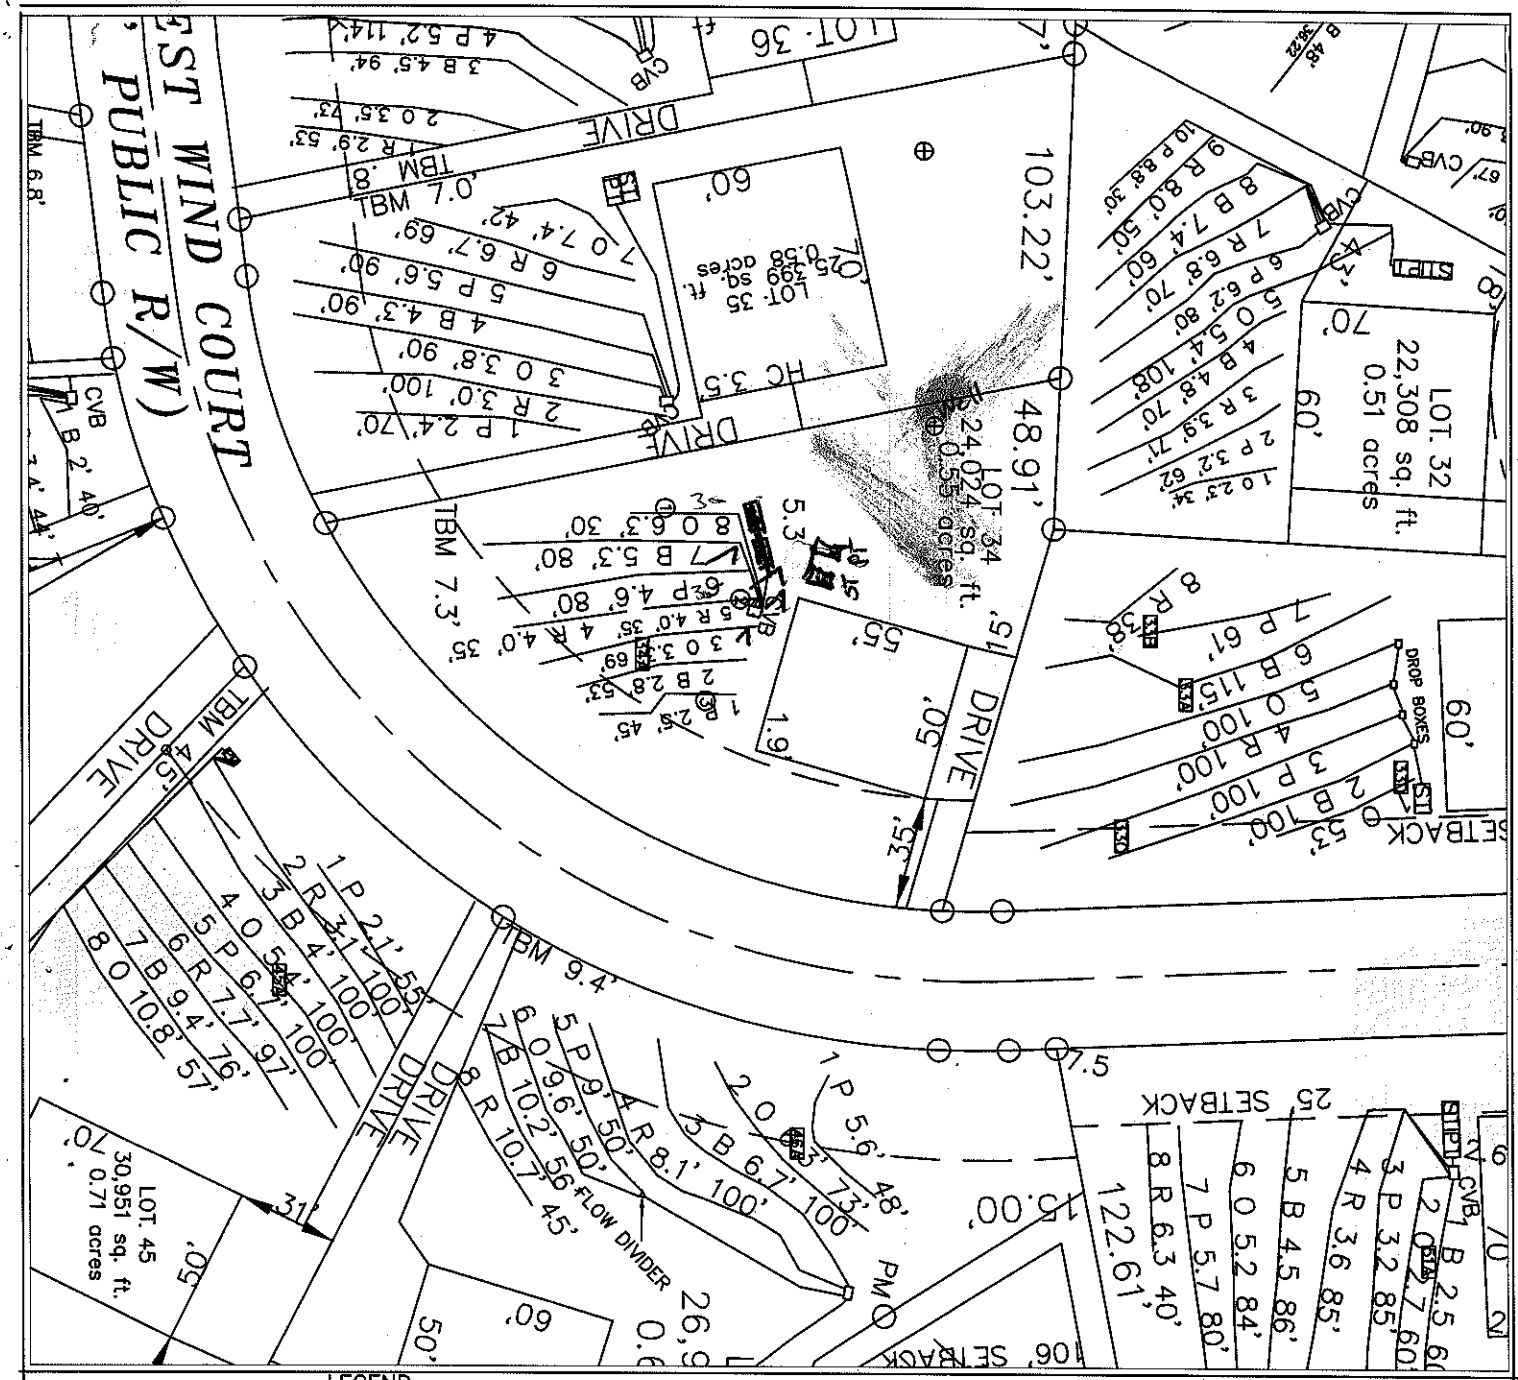

LEGEND

House Box.

System lines.

Repair lines.

GRAPHIC SCALE
1" = 60'

60 0 60 120

FOR PRELIMINARY PLANNING PURPOSES ONLY. ALL LOTS WILL REQUIRE FINAL APPROVAL BY THE COUNTY HEALTH DEPARTMENT ON A LOT BY LOT BASIS. THIS MAP SHOULD BY USED AS A GENERAL GUIDE, SOME ADJUSTMENTS WILL BE NECESSARY IN THE FIELD DUE TO SOIL VARIABILITY AND COMPLEX TOPOGRAPHIC FEATURES. THIS MAP ONLY REFLECTS EXISTING SOIL SUITABILITY FOR ON-SITE SEPTIC TANK SYSTEMS.

PLEASE REFER TO ATTACHED SOIL REPORT FOR ADDITIONAL SITE SPECIFIC INFORMATION

ROLLANS SOIL & ENVIRONMENTAL SERVICES
470 NORTH BROAD STREET SUITE D
MOORESVILLE, NC 28115
PHONE: (704) 658-1723
FAX: (704) 658-1724

BRADY FREEMAN, B.S.
MOBILE: (704) 746 - 6497
EMAIL: BFREE2009@YAHOO.COM

ASHLEY ROLLANS, NC LICENSED SOIL SCIENTIST
MOBILE: (704) 746 - 5046
EMAIL: ROLLANS@WINDSTREAM.NET

MAP TITLE: SITE PLAN & DRAINFIELD AREAS

PROJECT NAME: E&J DEVELOPMENT/AUTUMN GROVE SUBDIVISION

LOCATION/DATE: HWY 21/115 IREDELL COUNTY, NORTH CAROLINA AUGUST 2007

JOB # : 01-1043
FILE: C:\JOBS\01-1043
PROJECT MGR.: C.B.F.
FIELD WORK: C.B.F., A.L.P. & M.D.B.
DRAWN BY: C.B.F. & M.D.B.