Site Address: 133 Early Frost Ln - Mrsd

IREDELL COUNTY HEALTH DEPARTMENT

STATESVILLE 704-878-5305 MOORESVILLE 704-664-5281

IMPROVEMENT PERMIT / AUTHORIZATION TO CONSTRUCT / OPERATION PERMIT / EXISTING SYSTEM INSPECTION

PERMIT# 14752 19433 PIN# ~~4659 15 7617 .033~~ New Pin 4659153551 DATE 12/5/07

OWNER OR APPLICANT E+I DEVELOPMENT CO. / Essex Homes PHONE: Business 704-201-6465 Home

ADDRESS PO BOX 1065 HUNTERSVILLE, NC 28070

LOCATION 115-21 N TL CLEAR SPRINGS RD. TL AUTUMN GROVE LN TR EARLY FROST LN, TL HARVEST WIND CT., LOT ON R CORNER

SUBDIVISION AUTUMN GROVE BLOCK / SECTION 2 LOT 33 LOT AREA .59 SITE CLASS. PS DESIGN FLOW 480 L.T.A.R. .3

Septic Tank: 1000 Gallons: STB 160 Date 10-25-16

Pump Tank: ____ Gallons: PT ____ Date ____

Pump Make: ____ Model ____ Serial No. ____

Nitrification Field: No Fields 1 Square Feet 1200 Linear Feet 400

No Lines 4@100 Trench Width 3 Max Trench Bottom Depth 35" Gravel Depth NO

[X] New System [ ] Repair [ ] Expansion System Type: I II III IV V VI

System Description: GRAV - 25 REDUCTION

Repair System Description: PRES - 16" PPBPS

Maintenance Agreement Required: [ ] Yes [X] No

[X] House/Mod. Home No. Bedrooms 4

[ ] Mobile Home No. Persons 8

[ ] Business No. Employees ____

[ ] Other ____

Water Supply: [X] Individual [ ] Public [ ] Community

[X] Gravity [ ] Pressure [ ] Slab [X] Crawl Space [ ] Basement w/plumbing [ ] Basement wo/plumbing

Comments:/Conditions: FAST TRACK BY ROLLANS ENVIRONMENTAL (1) CONTRACTOR MUST HAVE COPY OF ROLLANS DESIGN + SITE PLAN ON SITE (2) CALL ICHD FOR CURRENT INFO BEFORE BEGINNING.

Comments:/Conditions: 6/25/16 Revised Floor plans, in Compliance with Septic plans

INITIAL SITE SKETCH

FAST TRACK / ROLLANS DESIGN

AS BUILT SKETCH


Permit can be suspended or revoked if any false information is supplied toward securing the permit/any unauthorized changes are made to the site/any unauthorized changes are made in the installation of the system. Improvement Permit with plat valid without expiration [ ] Improvement Permit with site plan valid for sixty months [X] Authorization to Construct is valid for a period equal to that of Improvement Permit – not to exceed sixty months.

Signed: ____ date 1-4-08 Installed by: SID GASKINS

Improvement Permit by: Wesley Sparks R.S. date 12/5/07 Operation Permit by: ____ date 12-14-16

Authorization to Construct by: Marvin Dotson R.S. date 6/25/16 Existing System Inspection by: ____ date ____

HEALTH DEPT. COPY: WHITE OWNER COPY (FINAL): YELLOW OWNER COPY (INITIAL): PINK

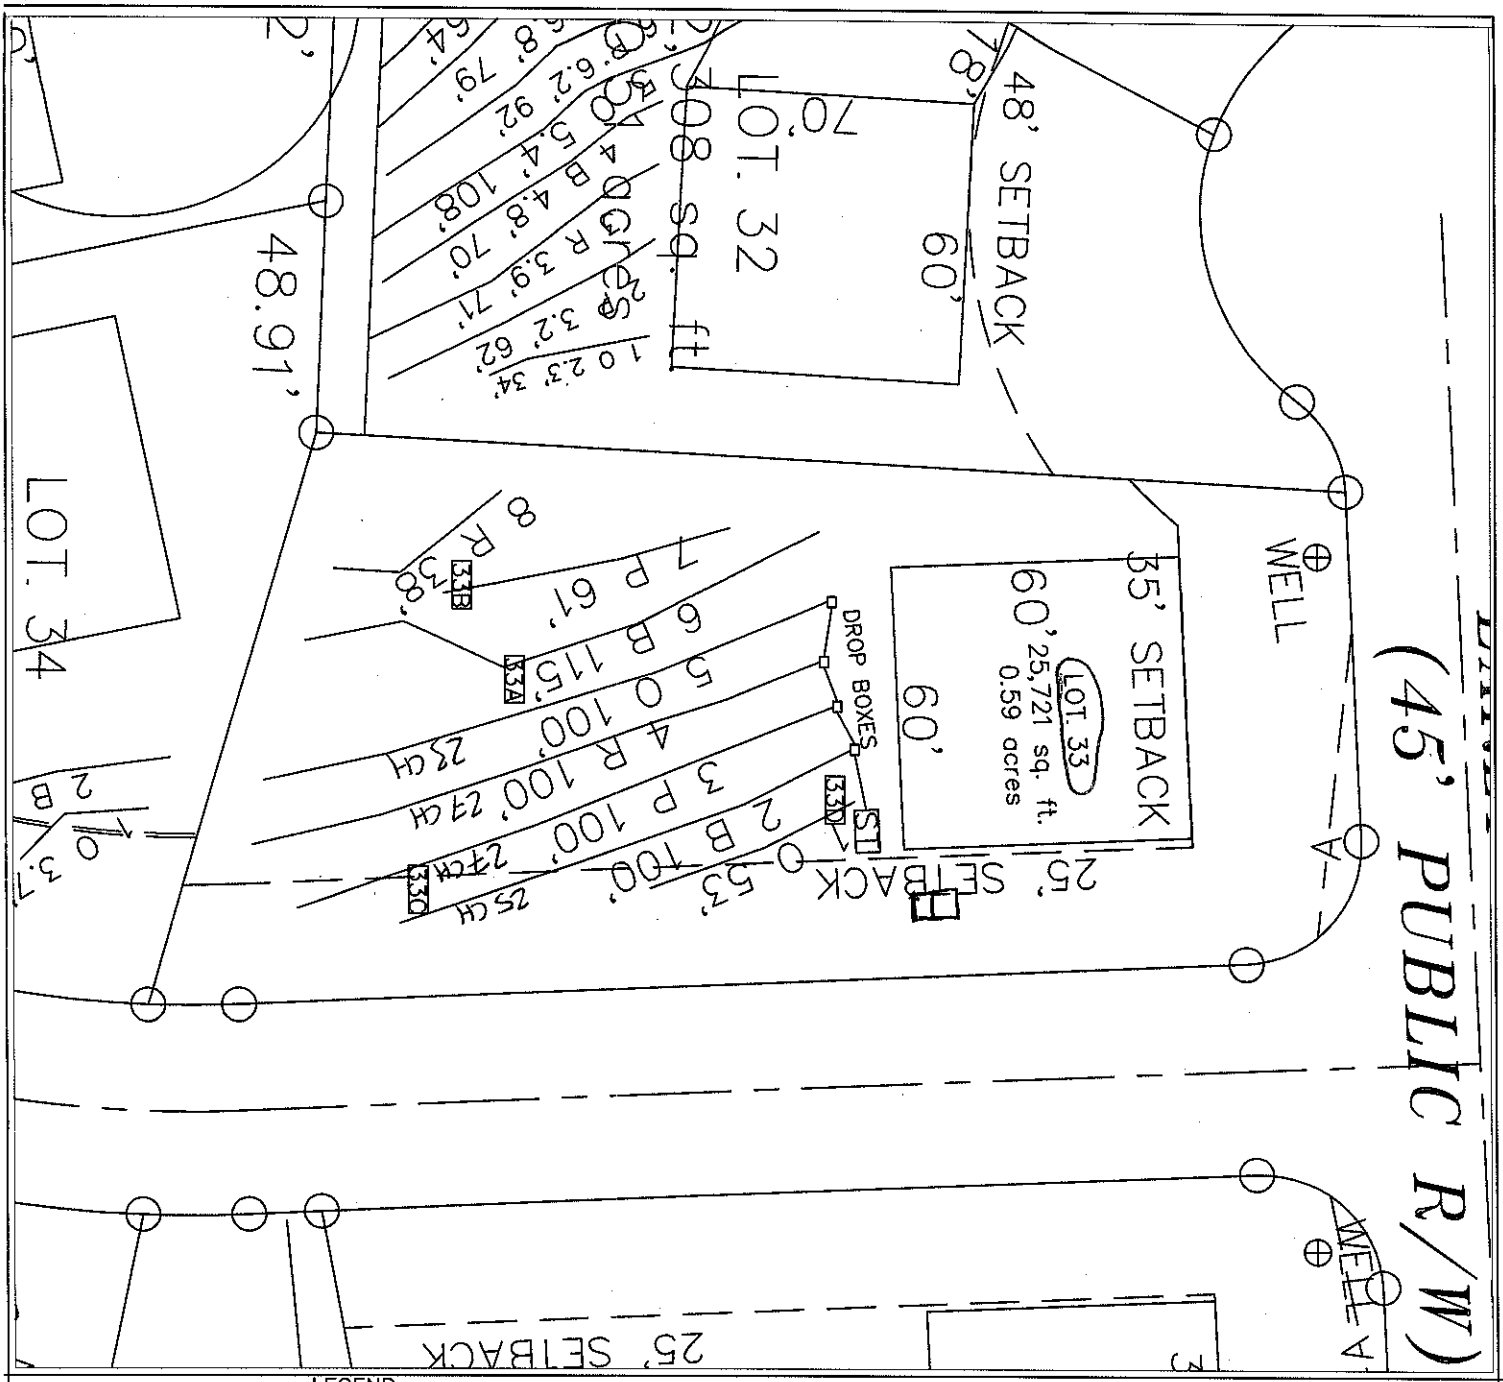

LEGEND

House Box.

System lines.

Repair lines.

GRAPHIC SCALE
1" = 40'

40 0 40 80

FOR PRELIMINARY PLANNING PURPOSES ONLY. ALL LOTS WILL REQUIRE FINAL APPROVAL BY THE COUNTY HEALTH DEPARTMENT ON A LOT BY LOT BASIS. THIS MAP SHOULD BY USED AS A GENERAL GUIDE, SOME ADJUSTMENTS WILL BE NECESSARY IN THE FIELD DUE TO SOIL VARIABILITY AND COMPLEX TOPOGRAPHIC FEATURES. THIS MAP ONLY REFLECTS EXISTING SOIL SUITABILITY FOR ON-SITE SEPTIC TANK SYSTEMS.

PLEASE REFER TO ATTACHED SOIL REPORT FOR ADDITIONAL SITE SPECIFIC INFORMATION

ROLLANS SOIL & ENVIRONMENTAL SERVICES
470 NORTH BROAD STREET SUITE D
MOORESVILLE, NC 28115
PHONE: (704) 658-1723
FAX: (704) 658-1724

BRADY FREEMAN, RS.
MOBILE: (704) 746-6497
EMAIL: BFREE2000@YAHOO.COM

ASHLEY ROLLANS, NC LICENSED SOIL SCIENTIST
MOBILE: (704) 746-5046
EMAIL: ROLLANS@WINDSTREAM.NET

MAP TITLE: SITE PLAN & DRAINFIELD AREAS

PROJECT NAME: E&J DEVELOPMENT/AUTUMN GROVE SUBDIVISION

LOCATION/DATE: HWY 21/115 IREDELL COUNTY, NORTH CAROLINA AUGUST 2007

JOB # : 01-1043
FILE: C:\JOBS\01-1043
PROJECT MGR.: C.B.F.
FIELD WORK: C.B.F., A.L.P. & M.D.B.
DRAWN BY: C.B.F. & M.D.B.