Site Address: 132 Early Frost Lane, Mrsvl.

IREDELL COUNTY HEALTH DEPARTMENT

STATESVILLE 704-878-5305 MOORESVILLE 704-664-5281

IMPROVEMENT PERMIT / AUTHORIZATION TO CONSTRUCT / OPERATION PERMIT / EXISTING SYSTEM INSPECTION

PERMIT# 147283 218162 PIN# 4659153826 V DATE 1-11-08

OWNER OR APPLICANT E & J Development Co. PHONE: Business _____ Home _____

ADDRESS PO Box 1065 Huntersville NC 28070

LOCATION Hwy 115 (21) N ti Clear Springs TL Autumn Grove TR Early Frost on right

SUBDIVISION Autumn Grove BLOCK / SECTION -2- LOT 27 LOT AREA .79 Ac. SITE CLASS. PS DESIGN FLOW 360gpd L.T.A.R. .3gpd/ft²

Septic Tank: 1000 Gallons; STB 1466 Date 7/9/16

Pump Tank: 1000 Gallons; PT 319 Date 8/16/16

Pump Make: _____ Model _____ Serial No. _____

Nitrification Field: No Fields 1 Square Feet 600 Linear Feet 200

No Lines 2 Trench Width 36" * Max Trench Bottom Depth 36" Gravel Depth NA ☐ Gravity ☒ Pressure

☒ New System ☐ Repair ☐ Expansion System Type: I II III (IV) V VI

System Description: LP PPBPS

Repair System Description: LP PPBPS

Maintenance Agreement Required: ☒ Yes ☐ No

☒ House/Mod. Home No. Bedrooms 3

☐ Mobile Home No. Persons 6

☐ Business No. Employees ____

☐ Other _____

Water Supply: ☒ Individual ☐ Public ☐ Community

☐ Slab ☒ Crawl Space ☐ Basement w/plumbing ☐ Basement wo/plumbing

Comments:/Conditions: Shave berm in system area
In-line filter in pump tank required
*per plan specs

Comments:/Conditions:

INITIAL SITE SKETCH

See plan from Rollins Soil & Environmental Services

AS BUILT SKETCH

11-14-16
SET 2' RH
CHECKED ELEC & ALARM BA


Permit can be suspended or revoked if any false information is supplied toward securing the permit/any unauthorized changes are made to the site/any unauthorized changes are made in the installation of the system. Improvement Permit with plat valid without expiration ☐ Improvement Permit with site plan valid for sixty months ☒ Authorization to Construct is valid for a period equal to that of Improvement Permit – not to exceed sixty months.

Signed: _____ date 2-19-08 Installed by: Water Management of NC

Improvement Permit by: Mickey Melville date 1-11-08 Operation Permit by: BA date 11-15-16

Authorization to Construct by: Tom Shuck date 5-20-16 Existing System Inspection by: _____ date _____

HEALTH DEPT. COPY: WHITE OWNER COPY (FINAL): YELLOW OWNER COPY (INITIAL): PINK

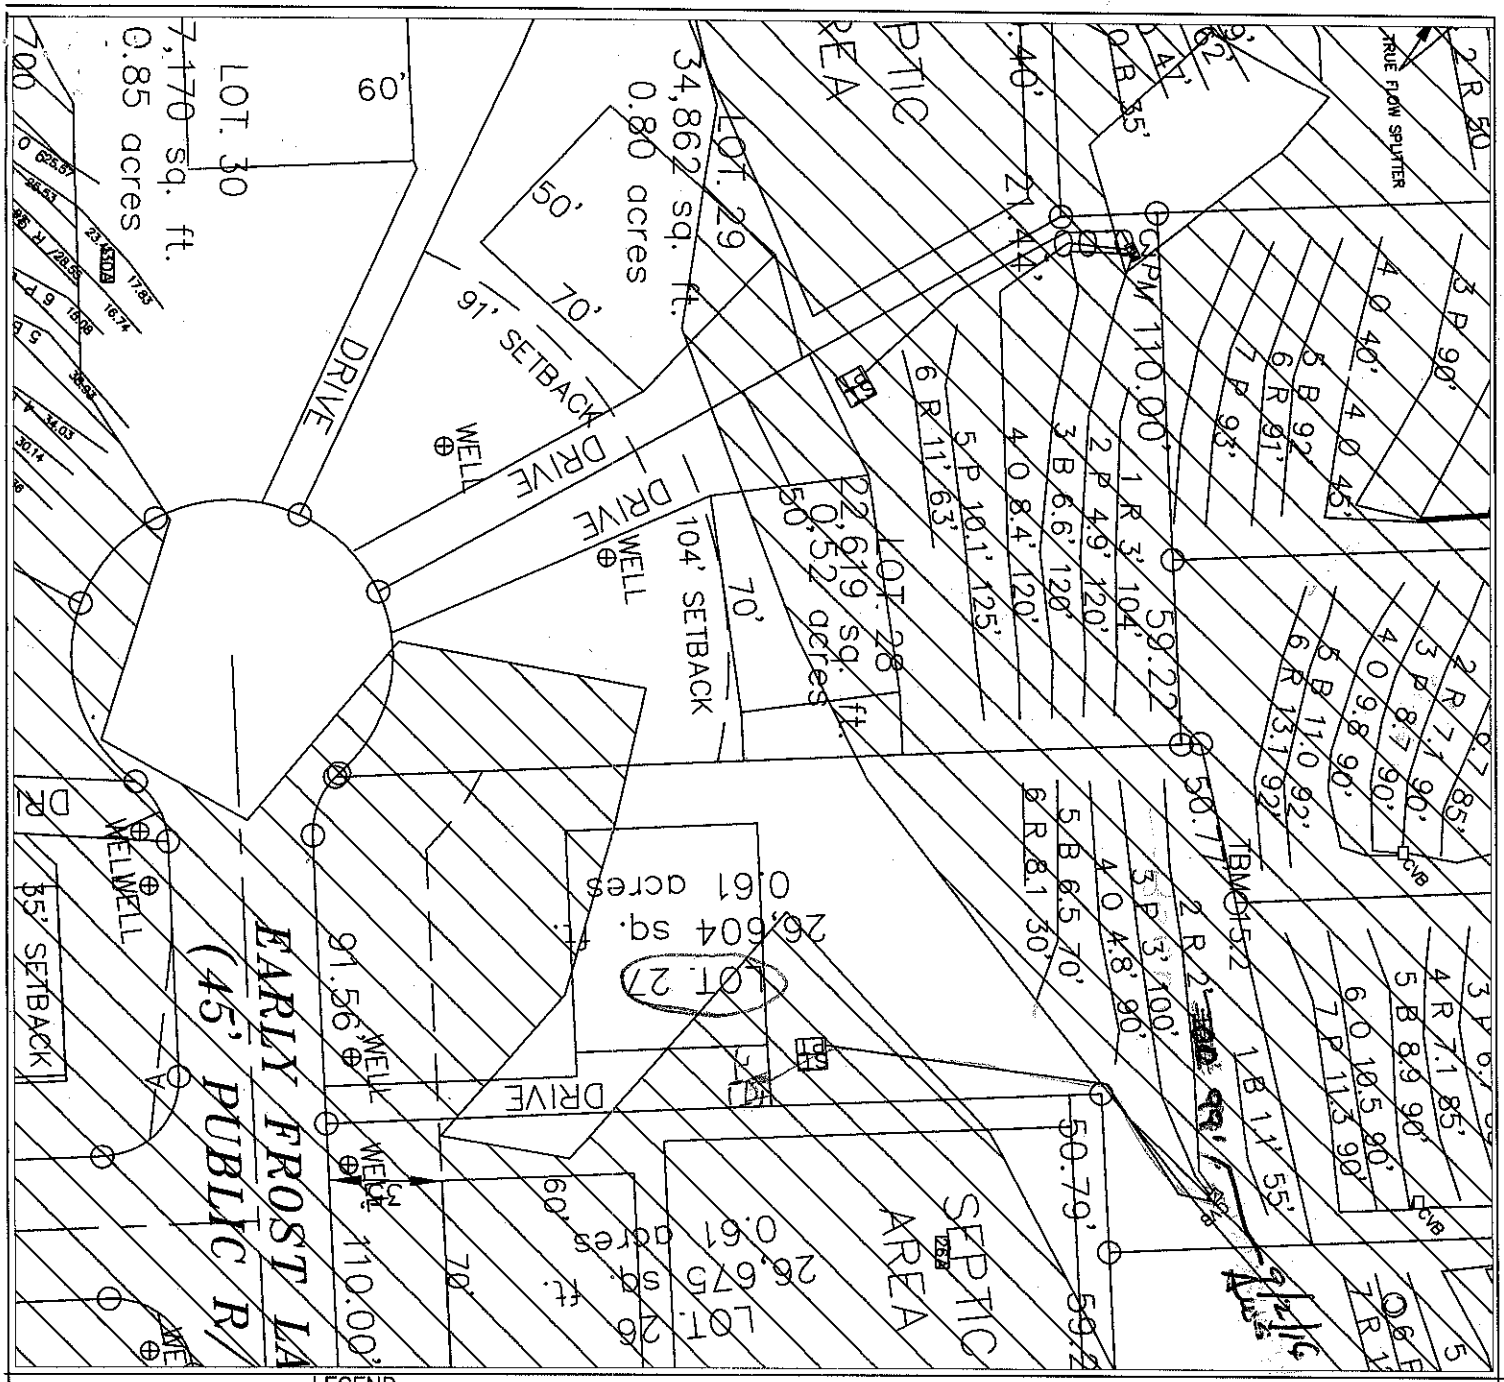

LEGEND

House Box.

System lines.

Repair lines.

GRAPHIC SCALE
1" = 60'

60 0 60 60

FOR PRELIMINARY PLANNING PURPOSES ONLY. ALL LOTS WILL REQUIRE FINAL APPROVAL BY THE COUNTY HEALTH DEPARTMENT ON A LOT BY LOT BASIS. THIS MAP SHOULD BY USED AS A GENERAL GUIDE, SOME ADJUSTMENTS WILL BE NECESSARY IN THE FIELD DUE TO SOIL VARIABILITY AND COMPLEX TOPOGRAPHIC FEATURES. THIS MAP ONLY REFLECTS EXISTING SOIL SUITABILITY FOR ON-SITE SEPTIC TANK SYSTEMS.

PLEASE REFER TO ATTACHED SOIL REPORT FOR ADDITIONAL SITE SPECIFIC INFORMATION

ROLLANS SOIL & ENVIRONMENTAL SERVICES
470 NORTH BROAD STREET SUITE D
MOORESVILLE, NC 28115
PHONE: (704) 658-1723
FAX: (704) 658-1724

BRADY FRIEDMAN, RS.
MOBILE: (704) 746-6497
EMAIL: BFREE2004@YAHOO.COM

ASHLEY ROLLANS, NC LICENSED SOIL SCIENTIST
MOBILE: (704) 746-5086
EMAIL: ROLLANS4@WINDSTREAM.NET

MAP TITLE: SITE PLAN & DRAINFIELD AREAS

PROJECT NAME: E&J DEVELOPMENT/AUTUMN GROVE SUBDIVISION

LOCATION/DATE: HWY 21/115 IREDELL COUNTY, NORTH CAROLINA AUGUST 2007

JOB # : 01-1043
FILE: C:\JOBS\01-1043
PROJECT MGR.: C.B.F.
FIELD WORK: C.B.F., A.L.P. & M.D.B.
DRAWN BY: C.B.F. & M.D.B.