Site Address: 146 Autumn Grove Ln - Mrsvl

IREDELL COUNTY HEALTH DEPARTMENT

STATESVILLE 704-878-5305 MOORESVILLE 704-664-5281

IMPROVEMENT PERMIT / AUTHORIZATION TO CONSTRUCT / OPERATION PERMIT / EXISTING SYSTEM INSPECTION

PERMIT# 1473T 2/8/64 PIN# 4659.15.7420 DATE 2-22-08

OWNER OR APPLICANT E+J Development Co. PHONE: Business 704-201-6465 Home

ADDRESS P.O. Box 1065 Huntersville NC 28070

LOCATION Hwy 21 N TL Clear Springs TL Autumn Grove on right past Early Frost

SUBDIVISION Autumn Grove BLOCK / SECTION 2 LOT 52 LOT AREA 1.14 Ac. SITE CLASS. DESIGN FLOW L.T.A.R.

Septic Tank: 1000 Gallons; STB 1160 Date 7-18-16
Pump Tank: 1000 Gallons; PT 319 Date 7-25-16
Pump Make: Model Serial No.
Nitrification Field: No Fields 1 Square Feet 825 Linear Feet 275
No Lines 3 Trench Width 36" * Max Trench Bottom Depth 36"

☒ New System ☐ Repair ☐ Expansion System Type: I II III (IV) V VI
System Description: LPPPBPS
Repair System Description: LPPPBPS
Maintenance Agreement Required: ☒ Yes ☐ No

☒ House/Mod. Home No. Bedrooms 4
☐ Mobile Home No. Persons 8
☐ Business No. Employees
☐ Other

Water Supply: ☒ Individual ☐ Public ☐ Community

Gravel Depth NA ☐ Gravity ☒ Pressure ☐ Slab ☒ Crawl Space ☐ Basement w/plumbing ☐ Basement wo/plumbing

Comments:/Conditions: * per plan specs
Fill gullies
In-line pump filter required

INITIAL SITE SKETCH

See plan from Rollins Soil & Environmental Services

Comments:/Conditions:

AS BUILT SKETCH

11-14-16
SET 21 PH
CHECKED ELEC. & ALARM RA

	Date	Initials
Drain Lines Checked	9/13	WS
Tanks Checked	9/13	WS
Pressure Manifold or Valve Box Checked	11-4	RA
Pressure Head Set		RA
Electrical Checked		RA
Floats Set		RA
Alarm Checked		RA
Maintenance Contract (Y) N		

Permit can be suspended or revoked if any false information is supplied toward securing the permit/any unauthorized changes are made to the site/any unauthorized changes are made in the installation of the system. Improvement Permit with plat valid without expiration ☐ Improvement Permit with site plan valid for sixty months ☒ Authorization to Construct is valid for a period equal to that of Improvement Permit – not to exceed sixty months.

Signed: date

Improvement Permit by: date 2-22-08


Authorization to Construct by: date 5-20-16

Installed by: Water Mangement

Operation Permit by: date 11-15-16

Existing System Inspection by: date

HEALTH DEPT. COPY: WHITE OWNER COPY (FINAL): YELLOW OWNER COPY (INITIAL): PINK

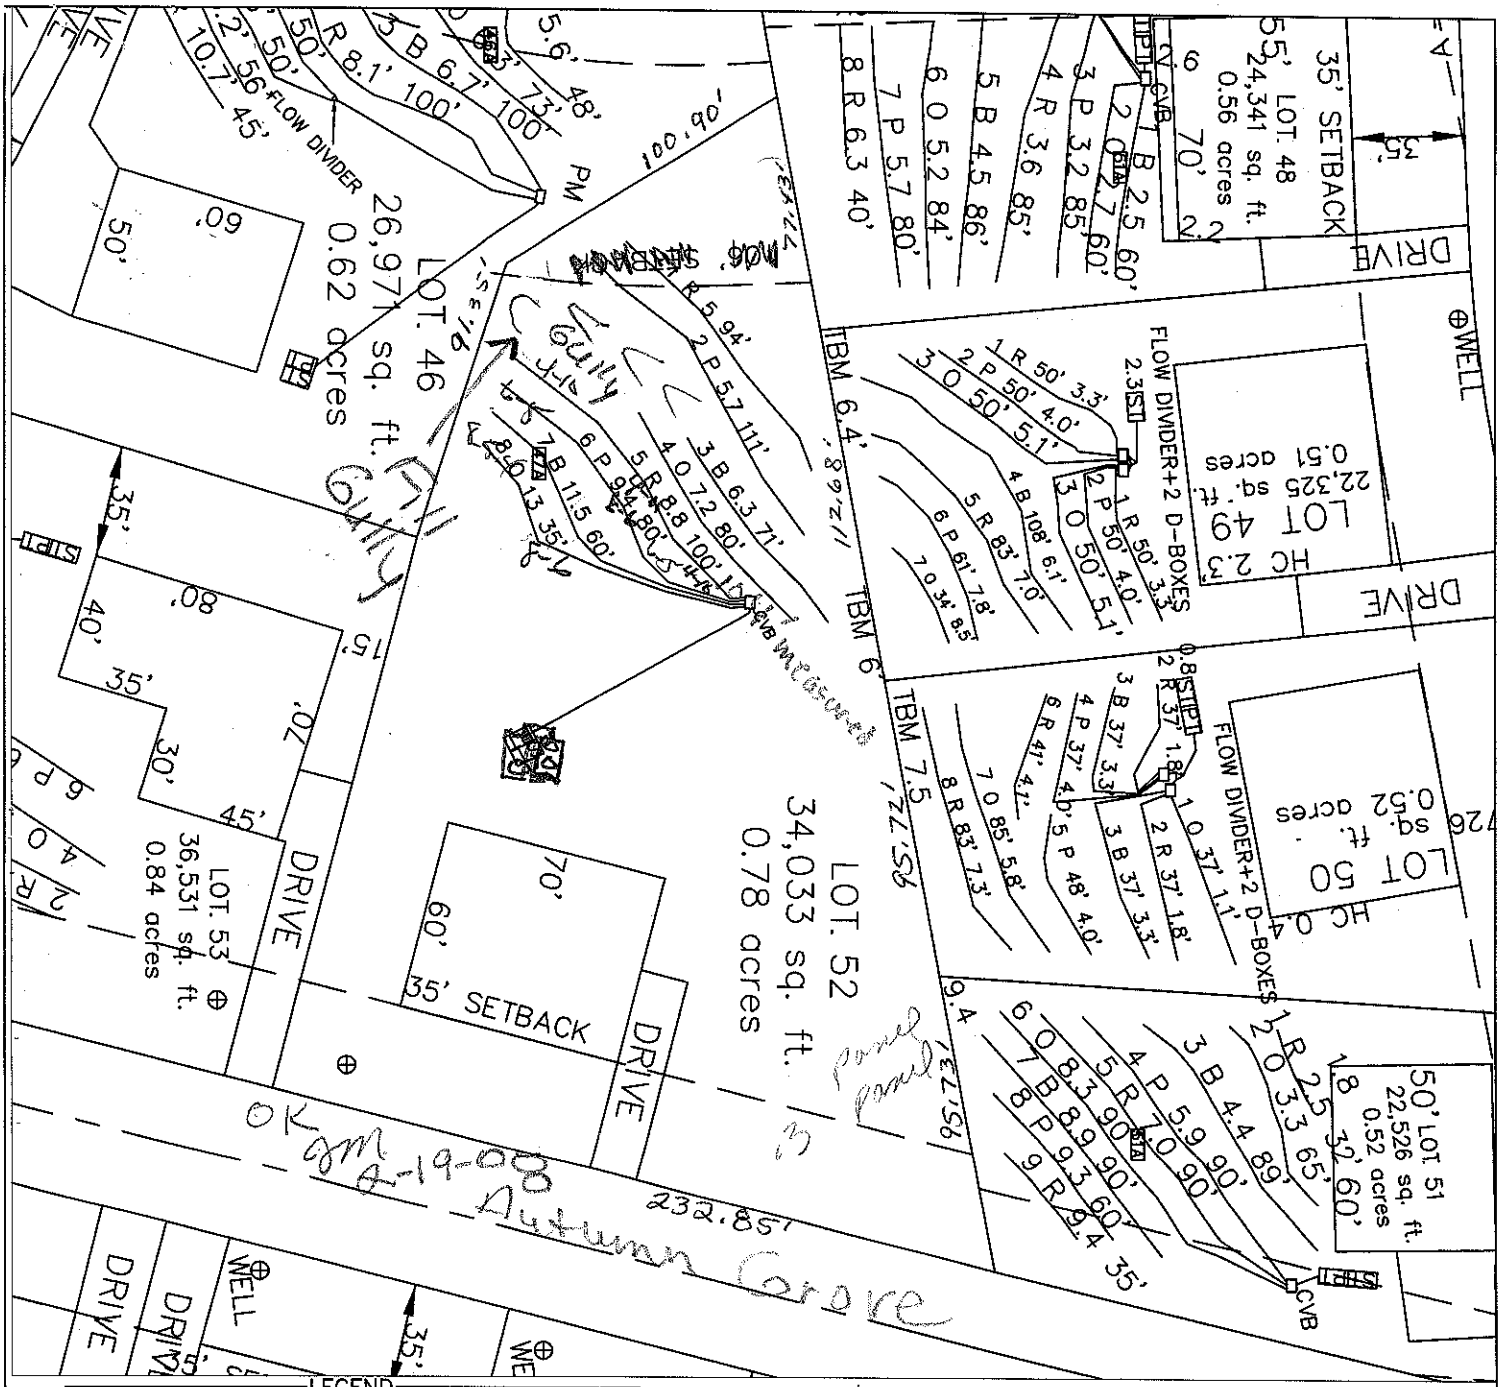

LEGEND

House Box.

System lines.

Repair lines.

#52 used to be 52 + part 47

GRAPHIC SCALE

1" = 60'

60 0 60 120

FOR PRELIMINARY PLANNING PURPOSES ONLY. ALL LOTS WILL REQUIRE FINAL APPROVAL BY THE COUNTY HEALTH DEPARTMENT ON A LOT BY LOT BASIS. THIS MAP SHOULD BY USED AS A GENERAL GUIDE, SOME ADJUSTMENTS WILL BE NECESSARY IN THE FIELD DUE TO SOIL VARIABILITY AND COMPLEX TOPOGRAPHIC FEATURES. THIS MAP ONLY REFLECTS EXISTING SOIL SUITABILITY FOR ON-SITE SEPTIC TANK SYSTEMS.

PLEASE REFER TO ATTACHED SOIL REPORT FOR ADDITIONAL SITE SPECIFIC INFORMATION

ROLLANS SOIL & ENVIRONMENTAL SERVICES
470 NORTH BROAD STREET SUITE D
MOORESVILLE, NC 28115
PHONE: (704) 658-1723
FAX: (704) 658-1724

BRADY FREEMAN, R.S.
MOBILE: (704) 746 - 4497
EMAIL: BFREE2098@YAHOO.COM

ASHLEY ROLLANS, NC LICENSED SOIL SCIENTIST
MOBILE: (704) 746 - 3046
EMAIL: ROLLANS@WINDSTREAM.NET

MAP TITLE: SITE PLAN & DRAINFIELD AREAS

PROJECT NAME: E&J DEVELOPMENT/AUTUMN GROVE SUBDIVISION

LOCATION/DATE: HWY 21/115 IREDELL COUNTY, NORTH CAROLINA AUGUST 2007

JOB # : 01-1043
FILE: C:\JOBS\01-1043
PROJECT MGR.: C.B.F.
FIELD WORK: C.B.F., A.L.P. & M.D.B.
DRAWN BY: C.B.F. & M.D.B.