IREDELL COUNTY HEALTH DEPARTMENT


ENVIRONMENTAL HEALTH DIVISION

PAGE 2: *SITE PLAN WORKSHEET*

SEE THE "SAMPLE SITE PLAN" BELOW. ***INCOMPLETE SITE PLANS WILL BE RETURNED TO YOU FOR COMPLETION AND MAY RESULT IN A DELAY IN THE ISSUANCE OF YOUR SEPTIC SYSTEM PERMIT!!!***

Place an (X) beside each item as you complete the site plan:

- (✓) Property Line measurements are clearly identified
- (✓) All proposed structures are indicated
- (✓) Front and side setbacks from property line
- (✓) Preferred driveway location and well location
- (✓) Area you prefer your septic system to be placed
- (✓) North arrow, or other sufficient indicator of direction

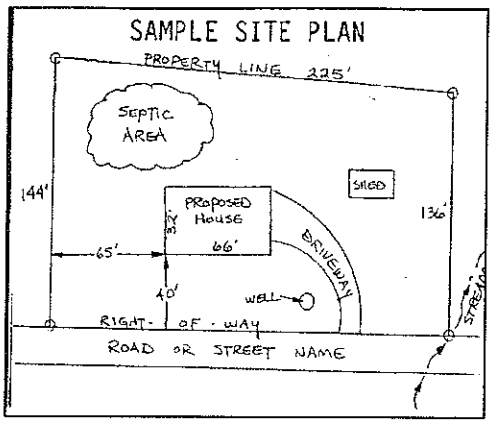

Circle N/A on the following if appropriate:

Location of septic systems and wells within 100' of your property	N/A
Location of easements and rights of ways on your property	N/A
Location of any designated wetlands on the property	N/A

USE THIS SPACE TO DRAW YOUR SITE PLAN

Show: proposed house or business footprint, wells, water lines, patios, pools and decks, and any other item that will occupy space on the site

☐ See enclosed plot plan.

Signature: _____

Property owner or owner's legal representative signature (SIGNATURE REQUIRED)

4-18-16

DATE

IREDELL COUNTY HEATLH DEPARTMENT

PAGE 2: *SITE PLAN WORKSHEET*

SEE THE SAMPLE SITE PLAN BELOW. INCOMPLETE SITE PLANS WILL BE RETURNED TO YOU FOR COMPLETION AND MAY RESULT IN A DELAY IN THE ISSUANCE OF YOUR SEPTIC SYSTEM PERMIT!!!

Place an (X) beside each item as you complete the site plan:

- X Property Line measurements are clearly identified...
- X All proposed structures are indicated...
  SHOW: proposed house or business footprint, wells, water lines, patios, pools and decks, and any other item that will occupy space on the site
- X Front and side setbacks from property line...
- X Preferred driveway location and configuration, preferred well location...
- X Area you prefer your septic system to be placed...
- X North arrow, or other sufficient indicator of direction...

Circle N/A on the following if appropriate:


- X Location of septic systems and wells within 100' of your property... N/A
- X Location of easements and rights of ways on your property... N/A
- ___ Location of any designated wetlands on the property... N/A


Signature: C [signature] 12/11/07

Property owner or owner's legal representative signature (SIGNATURE REQUIRED) — DATE

USE THIS SPACE TO DRAW YOUR SITE PLAN

Seed Attached Site Plan

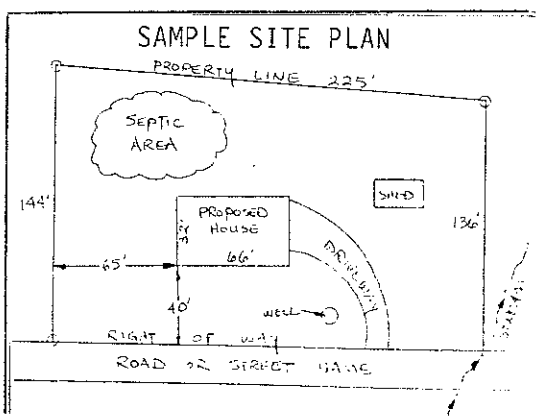

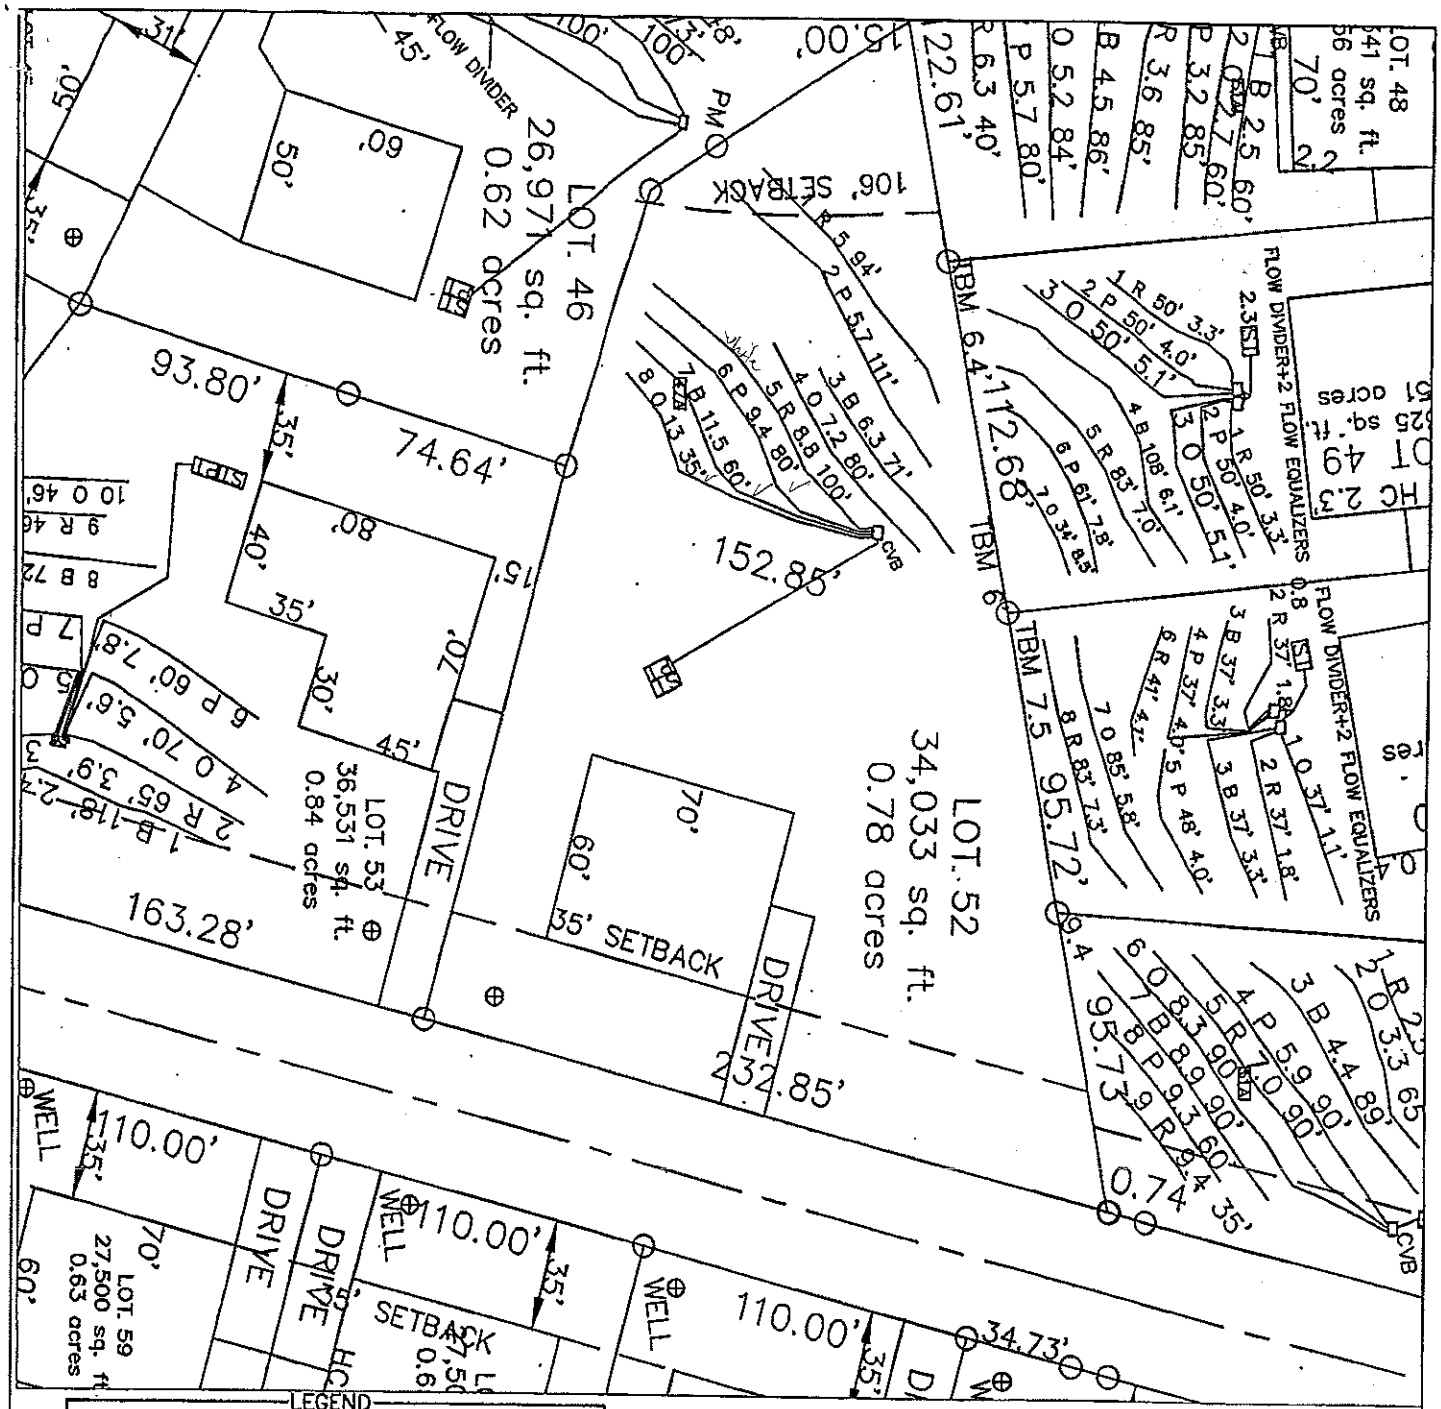

LEGEND

House Box.

System lines.

Repair lines.

GRAPHIC SCALE
1" = 60'

60 0 60 120

FOR PRELIMINARY PLANNING PURPOSES ONLY. ALL LOTS WILL REQUIRE FINAL APPROVAL BY THE COUNTY HEALTH DEPARTMENT ON A LOT BY LOT BASIS. THIS MAP SHOULD BY USED AS A GENERAL GUIDE, SOME ADJUSTMENTS WILL BE NECESSARY IN THE FIELD DUE TO SOIL VARIABILITY AND COMPLEX TOPOGRAPHIC FEATURES. THIS MAP ONLY REFLECTS EXISTING SOIL SUITABILITY FOR ON-SITE SEPTIC TANK SYSTEMS.

PLEASE REFER TO ATTACHED SOIL REPORT FOR ADDITIONAL SITE SPECIFIC INFORMATION


ROLLANS SOIL & ENVIRONMENTAL SERVICES
170 NORTH BROAD STREET SUITE D
MOORESVILLE, NC 28115
PHONE: (704) 658-1721
FAX: (704) 658-1724
EMAIL: BREEDLAW@AOL.COM
EMAIL: ROLLANSENVIRONMENTAL@NET

MAP TITLE: SITE PLAN & DRAINFIELD AREAS

PROJECT NAME: E&J DEVELOPMENT/AUTUMN GROVE SUBDIVISION

LOCATION/DATE: HWY 21/115 IREDELL COUNTY, NORTH CAROLINA AUGUST 2017


JOB # : 01-1043
FILE: C:\JOBS\01-1043
PROJECT MGR.: C.B.F.
FIELD WORK: C.B.F., A.L.F. & M.D.B.
DRAWN BY: C.B.F. & M.D.B.

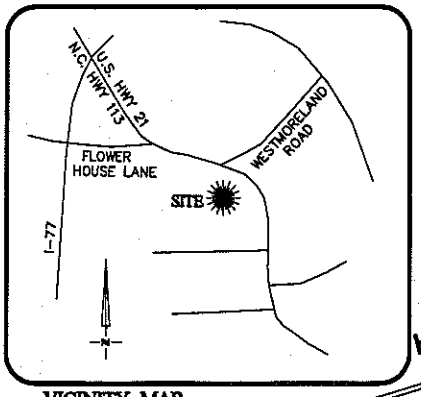


VICINITY MAP
Not To Scale

LINE TABLE		
LINE	LENGTH	BEARING
L1	15.00	N02°28'38"W
L2	45.18	N79°41'29"E

CURVE TABLE				
CURVE	BEARING	CHORD	LENGTH	RADIUS
C1	N17°18'32"E	142.61	144.29	272.50
C2	N00°10'08"W	21.95	21.96	272.50

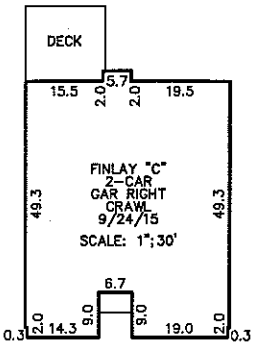

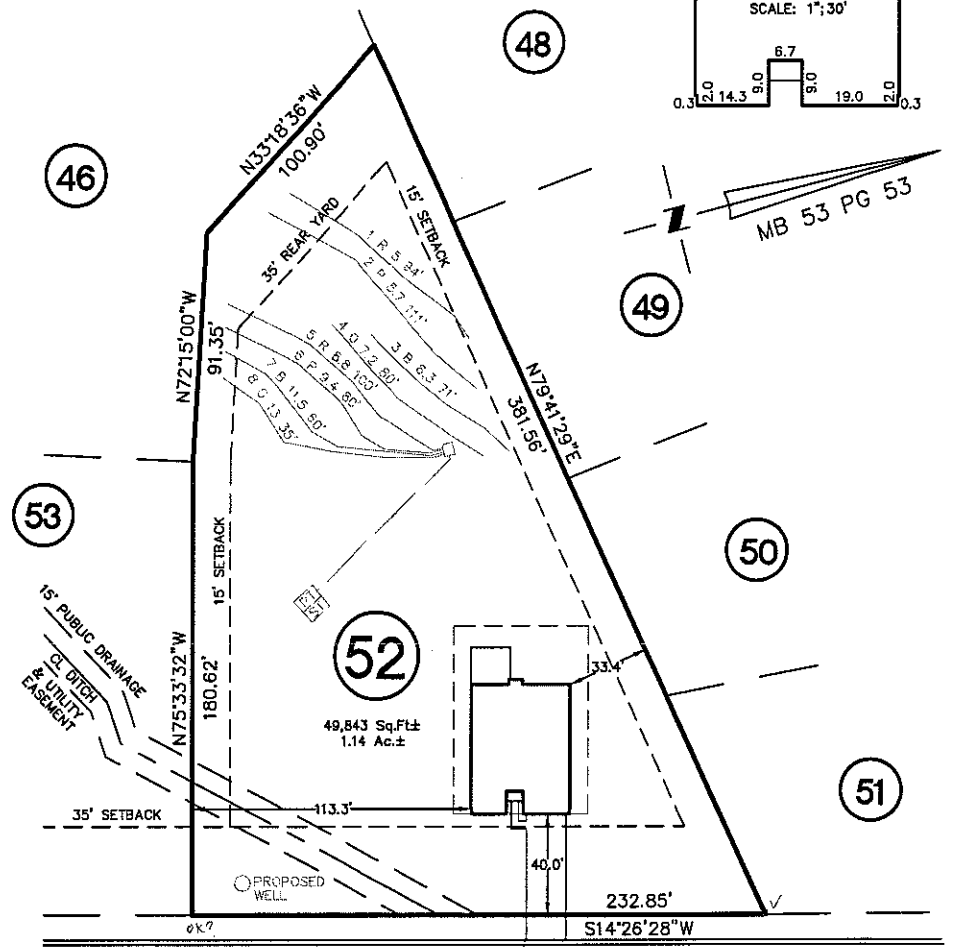

AUTUMN GROVE LANE

50' PUBLIC R/W

NOTE:
1. BUILDER ASSUMES RESPONSIBILITY FOR GRADING LOT AND/OR DESIGNING STEPS, PORCHES, DECKS, ETC. AS NECESSARY TO PREVENT ENCROACHMENT INTO SETBACKS.
2. HOUSE DIMENSIONS AND OPTIONS SHOULD BE VERIFIED WITH CONTRACTOR PRIOR TO CONSTRUCTION.
3. SETBACKS/ EASEMENTS SHOULD BE VERIFIED WITH DEVELOPER AND LOCAL OFFICIALS PRIOR TO CONSTRUCTION.
4. THIS IS A CONCEPTUAL DRAWING AND CONTENTS SHOWN HEREON ARE SUBJECT TO CHANGE UPON FINAL CONSTRUCTION.
THIS PROPERTY MAY BE SUBJECT TO ANY AND ALL APPLICABLE DEED RESTRICTIONS, EASEMENTS, RIGHT-OF-WAY, UTILITIES AND RESTRICTIVE COVENANTS WHICH MAY BE OF RECORD OR IMPLIED

THIS DRAWING DOES NOT REFLECT AS-BUILT INFORMATION

PRELIMINARY PLAT
NOT FOR RECORDATION, CONVEYANCES, OR SALES.

60 0 60
SCALE: 1" = 60'

EASTOVER
LAND SURVEYING COMPANY, P.A.
LAND SURVEYORS - PLANNERS (C-1833)
10430 PARK ROAD, SUITE #300
CHARLOTTE, NORTH CAROLINA 28210
PHONE (704) 927-8080
FAX (980) 309-0842

HOUSE LOCATION PLOT PLAN

FOR

LOT 52, AUTUMN GROVE SUBDIVISION, PHASE 2
Barringer Township, Iredell County, North Carolina

PROPERTY OF: ESSEX HOMES

MAP BOOK 53 PAGE 53 DEED REFERENCE

DRAWN BY: ERG | DATE: APRIL 14, 2016