IREDELL COUNTY HEALTH DEPARTMENT

STATESVILLE 704-878-5305 MOORESVILLE 704-664-5281

IMPROVEMENT PERMIT / AUTHORIZATION TO CONSTRUCT / OPERATION PERMIT / EXISTING SYSTEM INSPECTION

PERMIT # 145526 PIN # 4659157617.059 DATE 10-19-2010

OWNER or APPLICANT DG Homes PHONE: Business 704 400-2307 Home:

OWNER or APPLICANT ADDRESS 631-407 Brawley School Rd Mooresville, NC 28117

LOCATION / DIRECTIONS US 21 N/Hwy 115 North TL Clear Springs TL Autumn Grove Ln on left near end

SUBDIVISION Autumn Grove BLOCK / SECTION LOT # 59 LOT AREA .63 Ac. DESIGN FLOW 480gpd L.T.A.R. .3

Septic Tank 1000 Gallons: STB 1012 Date 2-2-09
Pump Tank 1000 Gallons: PT 17 Date 4-17-10
Pump Make Goulds Model 2HPWE0312M Serial # H100606
Nitrification Field No Fields 1 No Lines 4 Linear Feet 400'
Trench Width 36" Max. Trench Bottom Depth 36" Gravel Depth N/A

☒ New System ☐ Repair ☐ Expansion System Type I II III IV V VI
System Description: Pump (PM) 25% Reduction
Repair System Description: LPPPBPS
Maintenance Agreement Required ☐ YES ☒ NO (not Initially)
☐ GRAVITY ☒ PRESSURE


☒ Residence No. Bedrooms 4
☐ Business No. Persons
☐ Other No. Employees
☐ Slab ☐ Crawl Space
☐ Basement w/plumbing ☐ Basement w/o plumbing

Water Supply: ☒ Private ☐ Public ☐ Community


Comments / Conditions: Keep Septic System at least 10ft from PL (Keep line lengths within 10%)

Comments / Conditions: This permit replaces previous permit dated 11-13-07
30" cover on Tanks
Blacktopper 10/22/2010 Checked tanks & lines
10/28/2010 2ft pressure set

INITIAL SITE SKETCH

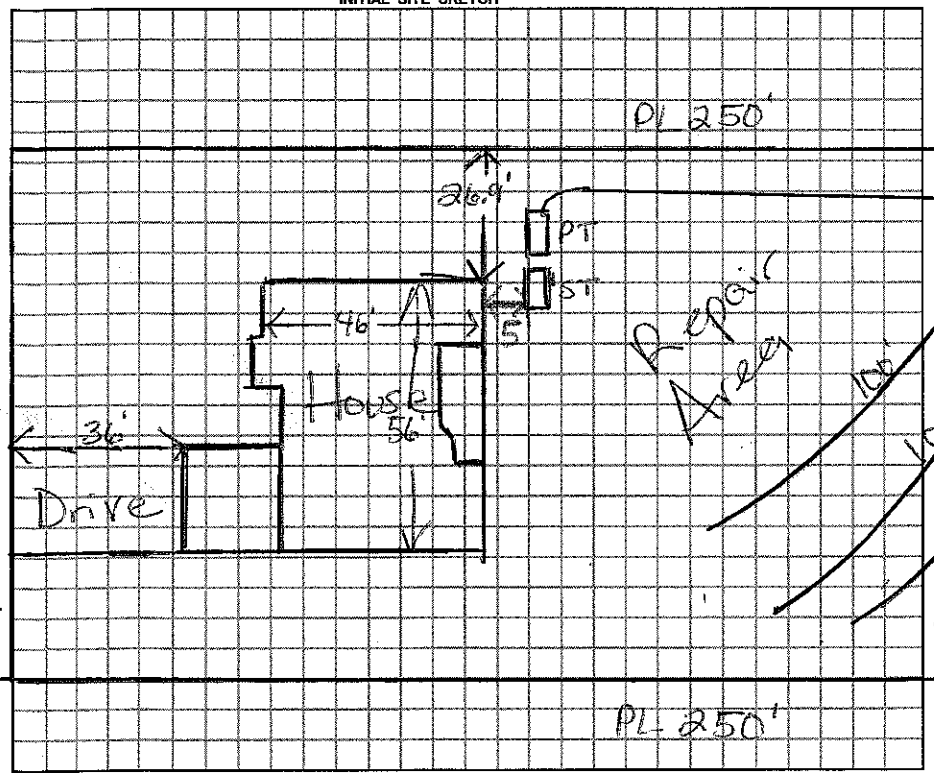

AS BUILT SKETCH

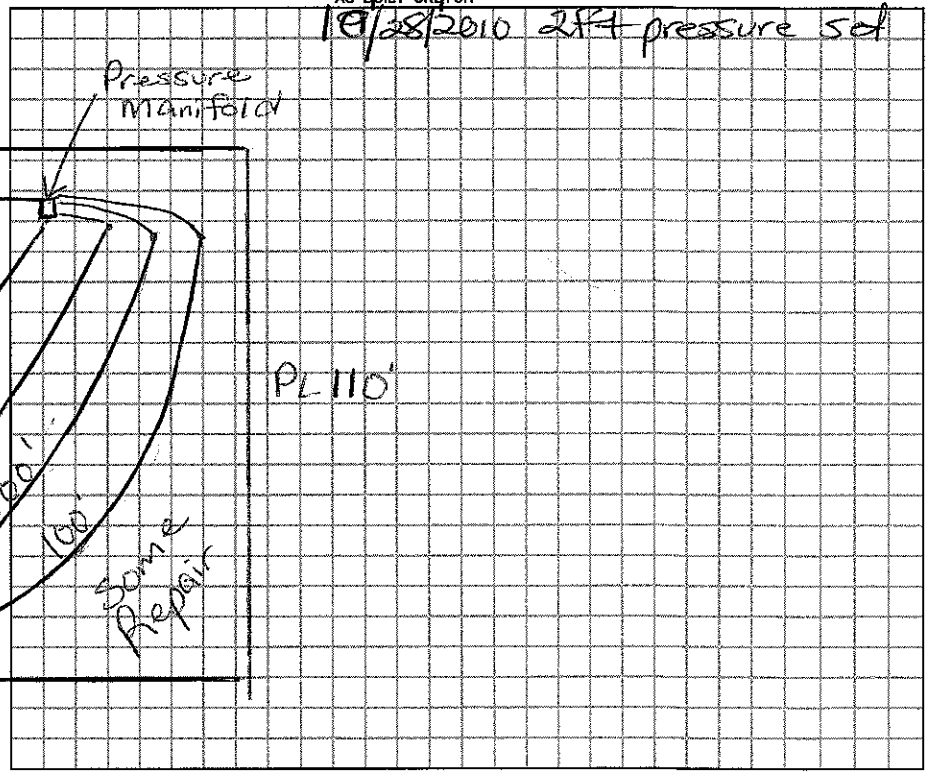

Permit can be suspended or revoked if any false information is supplied toward securing the permit / any unauthorized changes are made to the site / any unauthorized changes are made in the installation of the system.

☐ *IMPROVEMENT PERMIT w / plat valid without expiration.* ☐ *IMPROVEMENT PERMIT w / site plan valid for 60 mos.* ☐ *AUTHORIZATION TO CONSTRUCT valid for period equal to IMPROVEMENT PERMIT-not to exceed 60 mo.*

Owner / Applicant Signature: David Perry Date 10/19/2010 Installed by: Steve Dotson

Improvement Permit by: Marie H Dotson Date 10/19/2010 Operation Permit by: Marie H Dotson RS Date: 10/28/2010

Authorzation to Construct by: Marie H Dotson Date 10/19/2010 Existing System Inspected by: Date:

YOU SHOULD CONTACT A LOCATOR SERVICE PRIOR TO ANY EXCAVATION.

WHITE COPY Environmental Health YELLOW COPY (Final) Owner / Applicant PINK COPY (Initial) Owner / Applicant