


PRELIMINARY PLOT PLAN

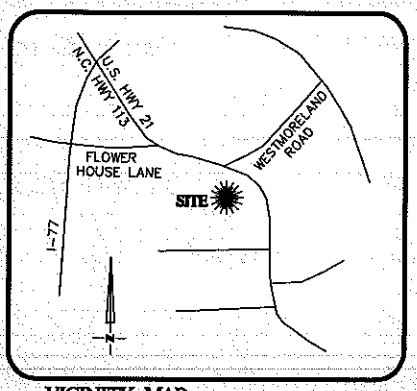

VICINITY MAP
Not To Scale

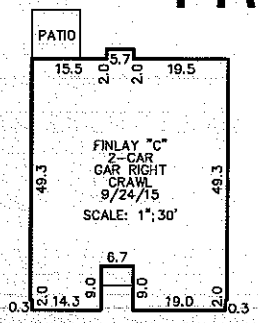

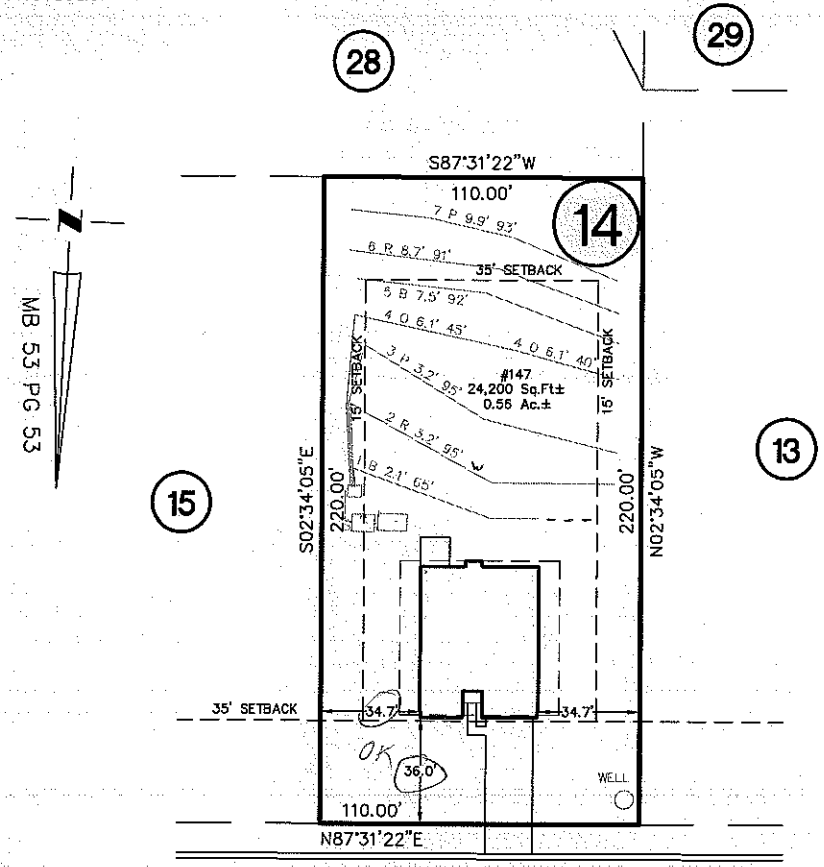

CLEAR SPRINGS ROAD

50' PUBLIC R/W

NOTE:
ALL LOTS ARE SUBJECT TO A 10' UTILITY AND DRAINAGE EASEMENT. 10' FEET ON EACH SIDE OF THE PROPERTY LINE.

NOTE:
1. BUILDER ASSUMES RESPONSIBILITY FOR GRADING LOT AND/OR DESIGNING STEPS, PORCHES, DECKS, ETC. AS NECESSARY TO PREVENT ENCROACHMENT INTO SETBACKS.
2. HOUSE DIMENSIONS AND OPTIONS SHOULD BE VERIFIED WITH CONTRACTOR PRIOR TO CONSTRUCTION.
3. SETBACKS/ EASEMENTS SHOULD BE VERIFIED WITH DEVELOPER AND LOCAL OFFICIALS PRIOR TO CONSTRUCTION.
4. THIS IS A CONCEPTUAL DRAWING AND CONTENTS SHOWN HEREON ARE SUBJECT TO CHANGE UPON FINAL CONSTRUCTION.
THIS PROPERTY MAY BE SUBJECT TO ANY AND ALL APPLICABLE DEED RESTRICTIONS, EASEMENTS, RIGHT-OF-WAY, UTILITIES AND RESTRICTIVE COVENANTS WHICH MAY BE OF RECORD OR IMPLIED

THIS DRAWING DOES NOT REFLECT AS-BUILT INFORMATION

PRELIMINARY PLAT
NOT FOR RECORDATION, CONVEYANCES, OR SALES.

50 0 50
SCALE: 1" = 50'

EASTOVER
LAND SURVEYING COMPANY, P.A.
LAND SURVEYORS - PLANNERS (C-1833)
10430 PARK ROAD, SUITE #300
CHARLOTTE, NORTH CAROLINA 28210
PHONE (704) 927-8080
FAX (980) 309-0842

HOUSE LOCATION PLOT PLAN

FOR

LOT 14, AUTUMN GROVE SUBDIVISION, PHASE 2
Barringer Township, Iredell County, North Carolina

PROPERTY OF: ESSEX HOMES

MAP BOOK 53 PAGE 53 DEED REFERENCE

DRAWN BY: ERG | DATE: APRIL 5, 2016