IREDELL COUNTY HEALTH DEPARTMENT

STATESVILLE 704-878-5305 MOORESVILLE 704-664-5281

IMPROVEMENT PERMIT / ~~CERTIFICATE OF COMPLETION~~ / OPERATION PERMIT / EXISTING SYSTEM INSPECTION

PROPERTY DESCRIPTION NO. 24900 DATE 6/25/97 TAX MAP NO. 4E A12 Watershed: ☒ Yes ☐ No

OWNER OR CONTRACTOR PRUITT DEV. CO. PHONE: Business Home 575-8001

ADDRESS 240 LAKEVIEW DR MOORESVILLE NC 28115 4659161066

LOCATION 21N - TL SEATRAIL - TL WHITE WATER - IN CUL-DE-SAC - 6TH LOT ON LT

SUBDIVISION WENWARD PT BLOCK / SECTION LOT 51 LOT AREA 21 780 SITE CLASS. RS DESIGN FLOW 360GPD L.T.A.R. .3 000/FT

Septic Tank: 1000 Gallons; STB 1017 Date 5/15/97

Pump Tank: Gallons; PT Date

Pump Make: Model Serial No.

Nitrification Field: No Fields 1 Square Feet 900 Linear Feet 300

No Lines 5@60 Trench Width 36" Max Trench Bottom Depth 36" Gravel Depth n/a

☒ New System ☐ Repair System Type: I, II, ☒ III, IV, V, VI

System Description: GRAVITY CHAMBERED

Repair System Description: SAME

Maintenance Agreement Required: ☐ Yes ☒ No

☐ House/Mod. Home ☐ Mobile Home ☐ Business ☐ Other

No. Bedrooms 3 No. Bathrooms 2 No. Employees


☐ Slab ☒ Crawl Space ☐ Basement w/plumbing ☐ Basement wo/plumbing

Water Supply: ☒ Individual ☐ Community ☐ Public


Comments:

Comments: WELL NOT IN PLACE AT TIME OF INSPECTION. MOBILE HOME NOT IN PLACE AT TIME OF INSPECTION.

INITIAL SITE SKETCH 1" = 50'

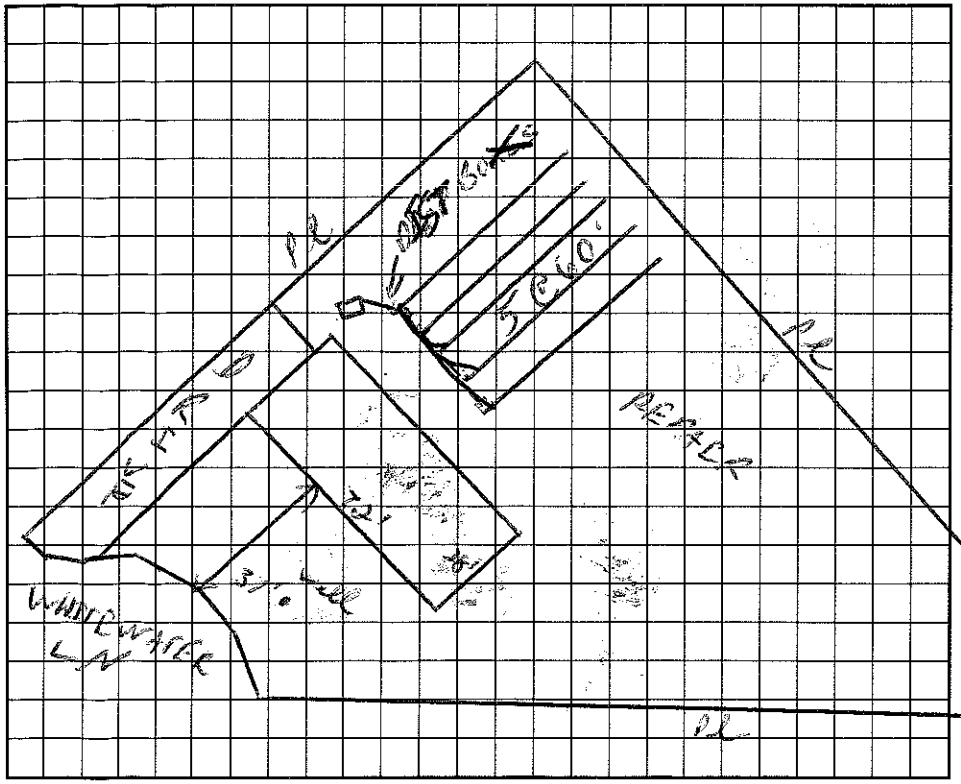

AS BUILT SKETCH

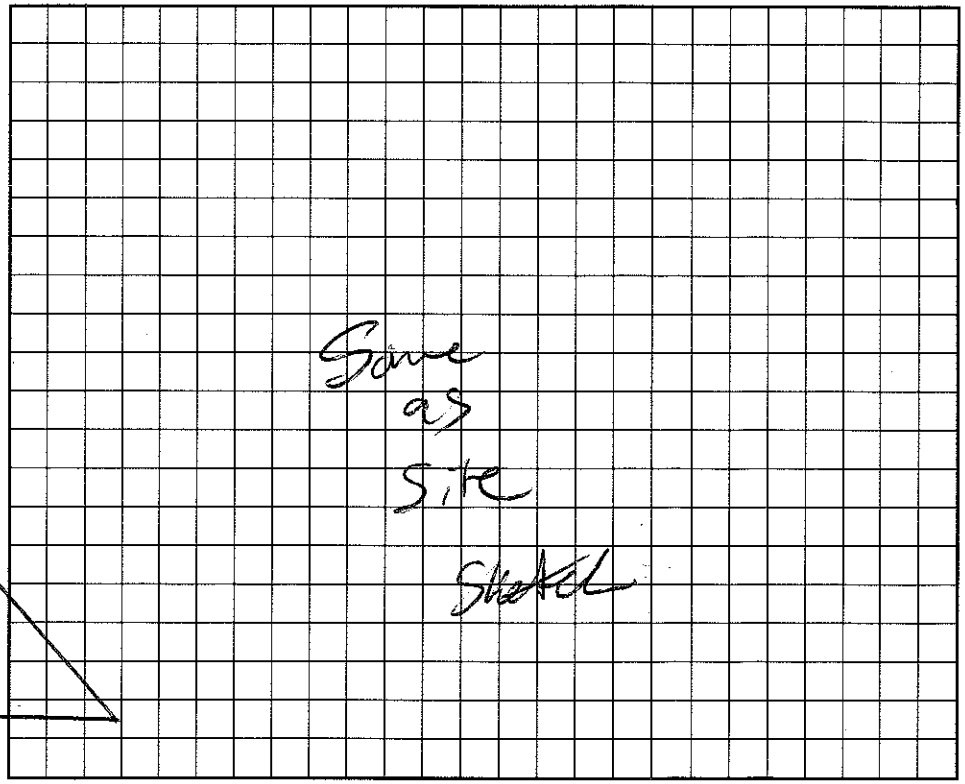

I understand that this permit can be suspended or revoked if any false information is supplied toward securing the permit/any unauthorized changes are made to the site/any unauthorized changes are made in the installation of the system. Improvement Permit is valid for 60 months from date of issuance.

Signed:

Improvement Permit by: date 6/25/97

~~Existing System Inspection by:~~ date 6/25/97

Installed by: A-1 BACKHOE

Certificate of Completion by: date

Operation Permit by:

~~H DEPT~~ COPY: WHITE INSPECTION COPY (FINAL): GREEN OWNER COPY (FINAL): YELLOW INSPECTION COPY (INITIAL): PINK OWNER COPY (I