IREDELL COUNTY HEALTH DEPARTMENT

Construction Auth. 4659161726

STATESVILLE 704-878-5305 MOORESVILLE 704-664-5281

IMPROVEMENT PERMIT / ~~CERTIFICATE OF COMPLETION~~ / OPERATION PERMIT / EXISTING SYSTEM INSPECTION

PROPERTY DESCRIPTION NO. 24901 DATE 5-27-97 TAX MAP NO. 4E A 12 Watershed: ☒ Yes ☐ No Lake IV C4

OWNER OR CONTRACTOR Pruitt Development PHONE: Business _____ Home _____

ADDRESS 142 Stutts Rd. Mooresville NC

LOCATION 21 N. TL Sailwinds TL Whitewater near cul-de-sac on left

SUBDIVISION Windward Pt BLOCK / SECTION 1 LOT 52 LOT AREA .5 Acre SITE CLASS. P.S DESIGN FLOW 360 gpd L.T.A.R. .3

Septic Tank: 1000 Gallons; STB 1612 Date 4/5/97
Pump Tank: _____ Gallons; PT _____ Date _____
Pump Make: _____ Model _____ Serial No. _____
Nitrification Field: No Fields 1 Square Feet 900' Linear Feet 300'
No Lines 4 at 75' Trench Width 3' Max Trench Bottom Depth 36" Gravel Depth N/A

☒ New System ☐ Repair System Type: I, II, III, IV, V, VI
System Description: Gravity Plastic Chamber
Repair System Description: Gravity/Pump Plastic Cham
Maintenance Agreement Required: ☐ Yes ☒ No


☐ House/Mod. Home ☒ Mobile Home ☐ Business ☐ Other
No. Bedrooms 3 No. Bathrooms ____ No. Employees ____
☐ Slab ☒ Crawl Space ☐ Basement w/plumbing ☐ Basement wo/plumbing

Water Supply: ☒ Individual ☐ Community ☐ Public

Comments: Install Drop boxes
Install inspection ports on ends.

Comments:
No well.

INITIAL SITE SKETCH Scale 1" = 40'

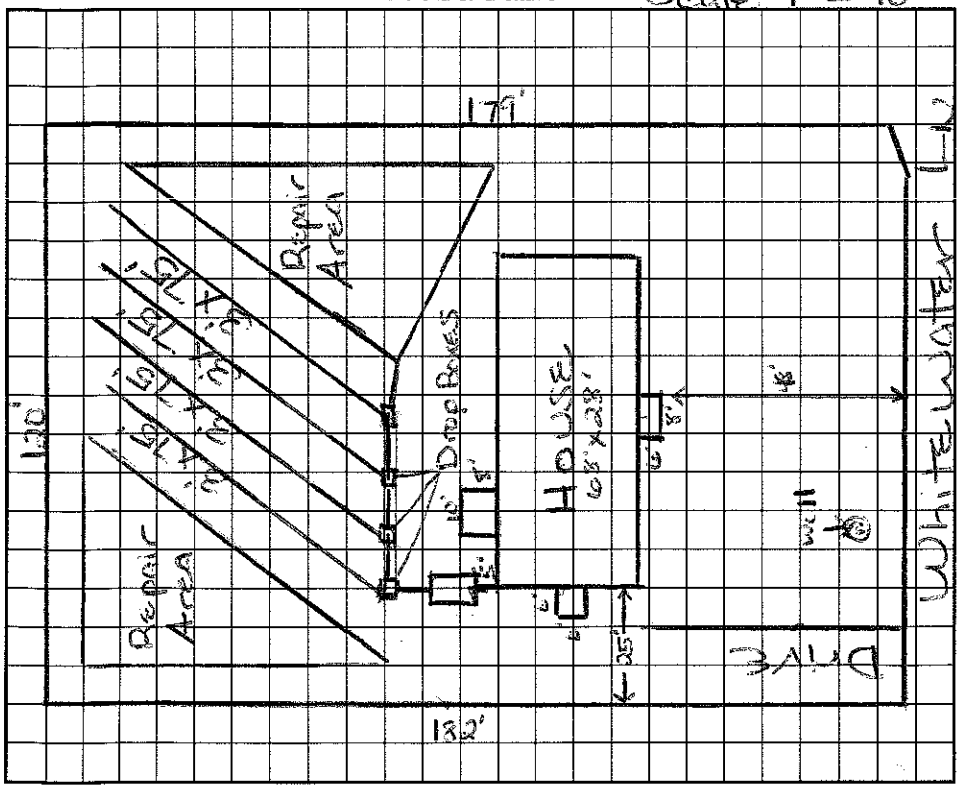

AS BUILT SKETCH

I understand that this permit can be suspended or revoked if any false information is supplied toward securing the permit/any unauthorized changes are made to the site/any unauthorized changes are made in the installation of the system. Improvement Permit is valid for 60 months from date of issuance.

Signed: _____

Improvement Permit by: Mark H. Dotson date 5/27/97

~~Existing System Inspection by:~~ Mark H. Dotson date 5/27/97

Installed by: Dennis Belcher

Certificate of Completion by: Wesley Sparks R.S. date 6/6/97

Operation Permit by: Wesley Sparks R.S. date 6/6/97

Auth. to HEALTH DEPT. COPY: WHITE INSPECTION COPY (FINAL): GREEN OWNER COPY (FINAL): YELLOW INSPECTION COPY (INITIAL): PINK OWNER COPY (INITIAL): GOLD