4659163890 (10:00)

IREDELL COUNTY HEALTH DEPARTMENT

STATESVILLE 704-878-5305 MOORESVILLE 704-664-5281

IMPROVEMENT PERMIT / CERTIFICATE OF COMPLETION / OPERATION PERMIT / EXISTING SYSTEM INSPECTION

PROPERTY DESCRIPTION NO. 24910 DATE 2-5-97 TAX MAP NO. 4E A 12 Watershed: ☐ Yes ☐ No

OWNER OR CONTRACTOR Pruitt Development PHONE: Business 875-8001 Home

ADDRESS 290 Lakeview Dr. Mooresville

LOCATION US 21 Turn on Sailwinds TL Regatta 5th lot RT

SUBDIVISION Windward Pt. BLOCK / SECTION LOT 61 LOT AREA 21780 SITE CLASS. PS DESIGN FLOW 360 L.T.A.R. .3

Septic Tank: 1000 Gallons; STB 786 Date 3-29-97

Pump Tank: Gallons; PT Date

Pump Make: Model Serial No.

Nitrification Field: No Fields 1 Square Feet 900 Linear Feet 300

No Lines 4 Trench Width 36" Max Trench Bottom Depth 36" Gravel Depth N/A

☑ New System ☐ Repair System Type: I, II, III, IV, V, VI

System Description: Gravity Chambers

Repair System Description: " "

Maintenance Agreement Required: ☐ Yes ☑ No

☐ House/Mod. Home ☑ Mobile Home ☐ Business ☐ Other

No. Bedrooms 3 No. Bathrooms 2 No. Employees

☐ Slab ☐ Crawl Space ☐ Basement w/plumbing ☐ Basement wo/plumbing

Water Supply: ☑ Individual ☐ Community ☐ Public


Comments:

Comments:

~~Inspection Fees Paid~~ AWS

NEED STB # ON S/T

INITIAL SITE SKETCH

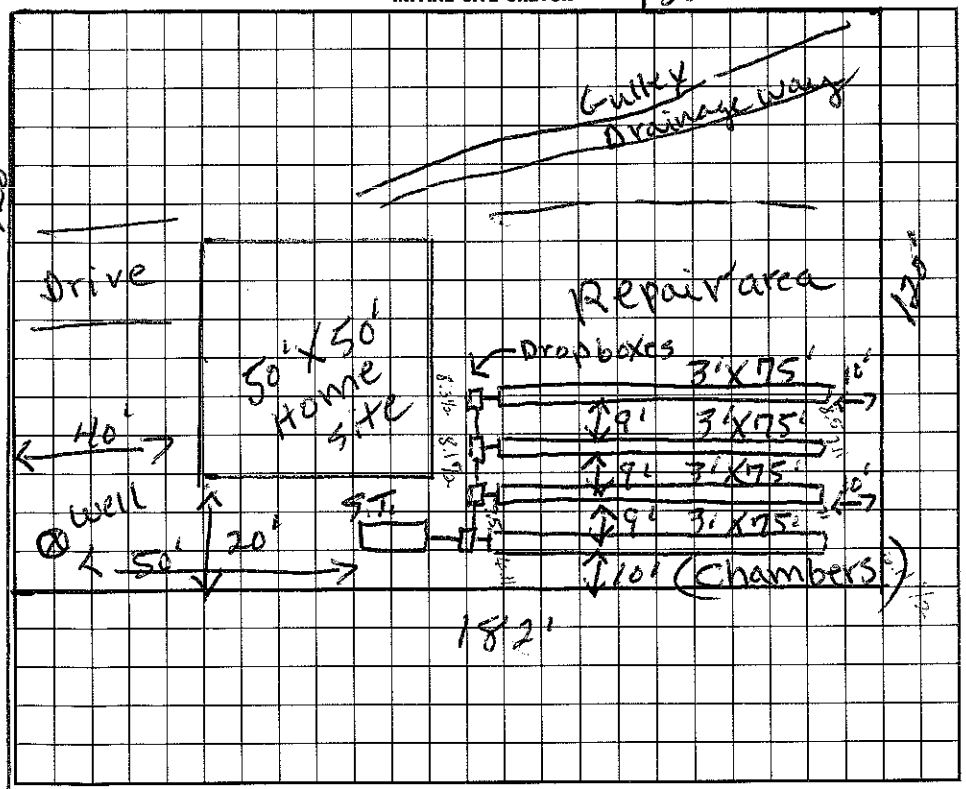

AS BUILT SKETCH

I understand that this permit can be suspended or revoked if any false information is supplied toward securing the permit/any unauthorized changes are made to the site/any unauthorized changes are made in the installation of the system. Improvement Permit is valid for 60 months from date of issuance.

Approved:

Improvement Permit by: R. C. Moore date 2-5-97

Final Inspection by: R. C. Moore date 2-5-97

Installed by: Danny Miller

Certificate of Completion by: Wesley Sparks R.S. date 5/8/97

Operation Permit by: Wesley Sparks R.S. date 5/8/97

DEPT. COPY: WHITE INSPECTION COPY (FINAL): GREEN OWNER COPY (FINAL): YELLOW INSPECTION COPY (INITIAL): PINK OWNER COPY (INITIAL): GOLD

Authorization to Count: Ex pires 60 days from issue