4659163922

IREDELL COUNTY HEALTH DEPARTM...

LATESVILLE 704-878-5305 MOORESVILLE 704-664-5281

IMPROVEMENT PERMIT / CERTIFICATE OF COMPLETION / OPERATION PERMIT / EXISTING SYSTEM INSPECTION

PROPERTY DESCRIPTION NO. 24909 DATE 6/11/97 TAX MAP NO. 4E A12 Watershed: ☒ Yes ☐ No

OWNER OR CONTRACTOR Pruitt Dave PHONE: Business _____ Home _____

ADDRESS 142 Stutts Rd Mooresville NC

LOCATION 2 L N. TL on Sailwinds TL onto Regatta LN 4th on RT

SUBDIVISION Lindwood Pt BLOCK / SECTION _____ LOT 60 LOT AREA .5 Acre SITE CLASS. PS DESIGN FLOW 360gpd L.T.A.R. .3

Septic Tank: _____ Gallons; STB 1012 Date 4/14/97

Pump Tank: _____ Gallons; PT _____ Date _____

Pump Make: _____ Model _____ Serial No. _____

Nitrification Field: No Fields 1 Square Feet 900 Linear Feet 300

No Lines 4 @ 75' Trench Width 36" Max Trench Bottom Depth 36" Gravel Depth N/A

☒ New System ☐ Repair System Type: I, II, (III), IV, V, VI

System Description: Gravity Plastic Chambers

Repair System Description: Gravity Plastic Chambers

Maintenance Agreement Required: ☐ Yes ☒ No

☐ House/Mod. Home No. Bedrooms 3

☒ Mobile Home No. Bathrooms ____

☐ Business No. Employees ____

☐ Other _____


☐ Slab ☒ Crawl Space ☐ Basement w/plumbing ☐ Basement wo/plumbing

Water Supply: ☒ Individual ☐ Community ☐ Public

Comments: Well must be at least 50' from Septic System.
Install Inspection ports at end of each lateral

Comments:

INITIAL SITE SKETCH Scale 1:50

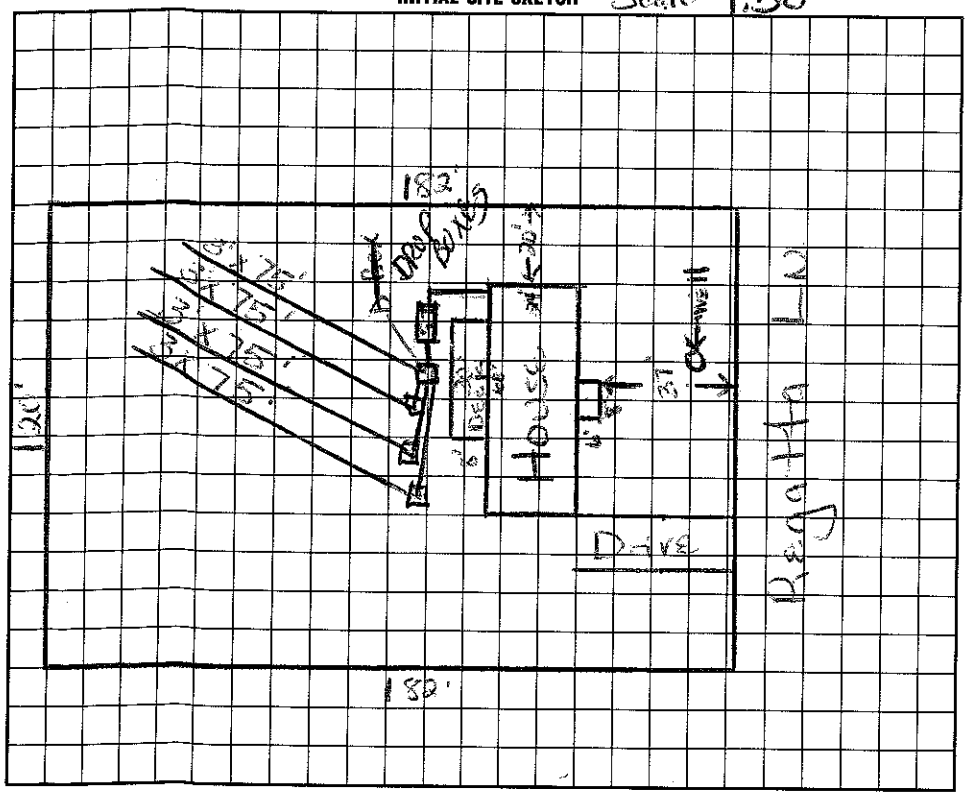

AS BUILT SKETCH

Same as Site Sketch

I understand that this permit can be suspended or revoked if any false information is supplied toward securing the permit/any unauthorized changes are made to the site/any unauthorized changes are made in the installation of the system. Improvement Permit is valid for 60 months from date of issuance.

Signed: Russell Olson

Improvement Permit by: Maria H.H. Dotson date 6/11/97

~~Existing System~~ Inspection by: Maria H.H. Dotson date 6/11/97

Installed by: A-1 BACKHOE

Certificate of Completion by: _____ date _____

Operation Permit by: C. Kelly Thomas date 6/17/97

Auth to Construct

HEALTH DEPT. COPY: WHITE INSPECTION COPY (FINAL): GREEN OWNER COPY (FINAL): YELLOW INSPECTION COPY (INITIAL): PINK OWNER COPY (INITIAL): GOLD