IREDELL COUNTY HEALTH DEPARTMENT

Auth to Construct 4959165824

STATESVILLE 704-878-5305 MOORESVILLE 704-664-5281

IMPROVEMENT PERMIT / ~~CERTIFICATE OF COMPLETION~~ / OPERATION PERMIT / EXISTING SYSTEM INSPECTION

PROPERTY DESCRIPTION NO. 24916 DATE 6/2/97 TAX MAP NO. 4EA12 Watershed: [X] Yes [ ] No

OWNER OR CONTRACTOR Dwight Dev. Co. PHONE: Business (800) 727-3633 Home

ADDRESS 142 Shutts, Mooresville, NC

LOCATION US 115/21 N. to Sailwinds TL Regatta 5th on Left

SUBDIVISION Woodward PH BLOCK / SECTION LOT 67 LOT AREA 120X183' SITE CLASS. PS DESIGN FLOW 360 gpd L.T.A.R. .3

Septic Tank: 1000 Gallons; STB 102 Date @ 2/18/97 [X] New System [ ] Repair System Type: I, II, III, IV, V, VI

Pump Tank: Gallons; PT Date

Pump Make: Model Serial No.

Nitrification Field: No Fields 1 Square Feet 900 Linear Feet 300

No Lines 4 at 75' Trench Width 3' Max Trench Bottom Depth 3" Gravel Depth N/A

System Description: Gravity Plastic Chamber

Repair System Description: Gravity Plastic Chamb.

Maintenance Agreement Required: [ ] Yes [ ] No

[X] House/Mod. Home [ ] Mobile Home [ ] Business [ ] Other

No. Bedrooms 3 No. Bathrooms 2 No. Employees


[ ] Slab [X] Crawl Space [ ] Basement w/plumbing [ ] Basement wo/plumbing

Water Supply: [X] Individual [ ] Community [ ] Public

Comments: ~~X~~ Install inspection ports near end of each lateral

Comments:

INITIAL SITE SKETCH Scale: 1:50

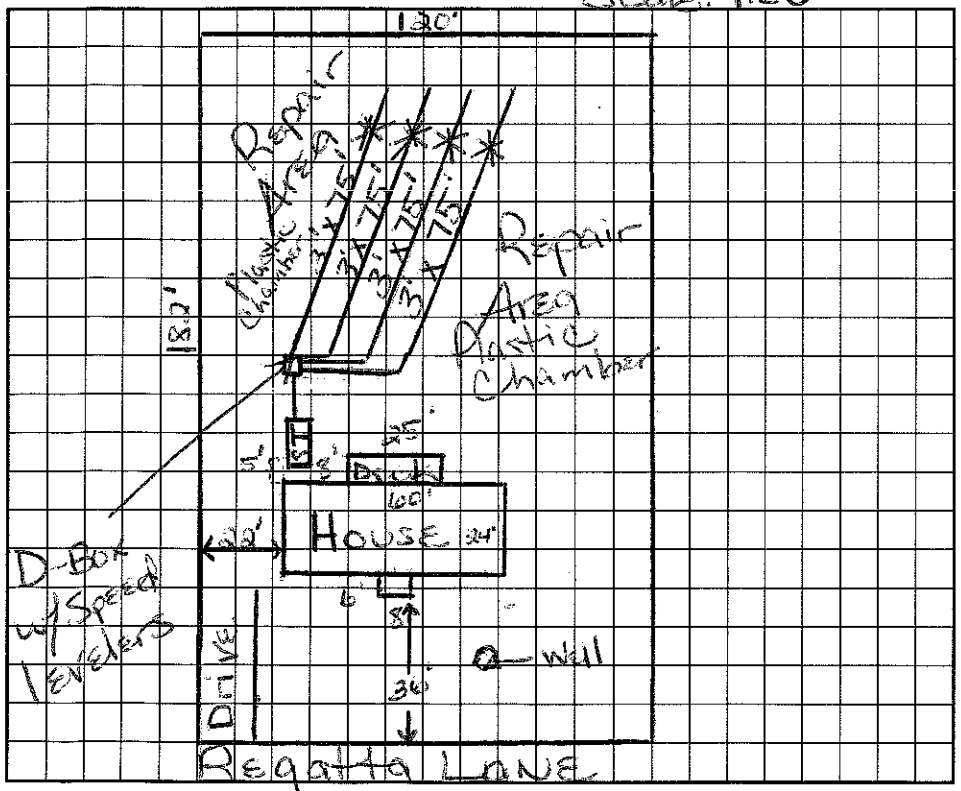

AS BUILT SKETCH

I understand that this permit can be suspended or revoked if any false information is supplied toward securing the permit/any unauthorized changes are made to the site/any unauthorized changes are made in the installation of the system. Improvement Permit is valid for 60 months from date of issuance.

Signed:

Improvement Permit by: Marvin H. Dotson date 6/3/97

~~Existing System Inspection by:~~ Marvin H. Dotson ~~date~~ 6/3/97

Construction Auth

Installed by: A1 Backhoe

Certificate of Completion by: date

Operation Permit by: C. date 9/24/97

HEALTH DEPT. COPY: WHITE INSPECTION COPY (FINAL): GREEN OWNER COPY (FINAL): YELLOW INSPECTION COPY (INITIAL): PINK OWNER COPY (INITIAL): GOLD