4659167777

IREDELL COUNTY HEALTH DEPARTMENT Cust. Auth

STATESVILLE 704-878-5305 MOORESVILLE 704-664-5281

IMPROVEMENT PERMIT / ~~CERTIFICATE OF COMPLETION~~ / OPERATION PERMIT / EXISTING SYSTEM INSPECTION

PROPERTY DESCRIPTION NO. 25095 DATE Feb 4 97 TAX MAP NO. part of 4EA12 Watershed: ☒ Yes ☐ No

OWNER OR CONTRACTOR Truitt Dev. Co. PHONE: Business _____ Home _____

ADDRESS 13420 Rosso Blvd. W. Huntersville 28078

LOCATION 115-21 N. TL Sailwinds TL Key West Dr on Right at Cul-D-Sac

SUBDIVISION Windward Pt. BLOCK / SECTION _____ LOT 77 LOT AREA .5Ac SITE CLASS. BSpv. 1576 DESIGN FLOW 360gpd L.T.A.R. .3

Septic Tank: 1000 Gallons; STB 32 1 Date 4/11/97

Pump Tank: _____ Gallons; PT _____ Date _____

Pump Make: _____ Model _____ Serial No. _____

Nitrification Field: No Fields 1 Square Feet 900 Linear Feet 300

No Lines 4@75' Trench Width 36" Max Trench Bottom Depth 36" Gravel Depth NA

☒ New System ☐ Repair System Type: I, II, III, IV, V, VI

System Description: gravity plastic chambered

Repair System Description: gravity / chambered / panel block

Maintenance Agreement Required: ☐ Yes ☒ No

☐ House/Mod. Home No. Bedrooms 3

☒ Mobile Home No. Bathrooms 2

☐ Business No. Employees _____

☐ Other _____

☐ Slab ☒ Crawl Space ☐ Basement w/plumbing ☐ Basement wo/plumbing


Water Supply: ☒ Individual ☐ Community ☐ Public

Comments:


Comments: 3 speed levelers used

INITIAL SITE SKETCH

1"=50'

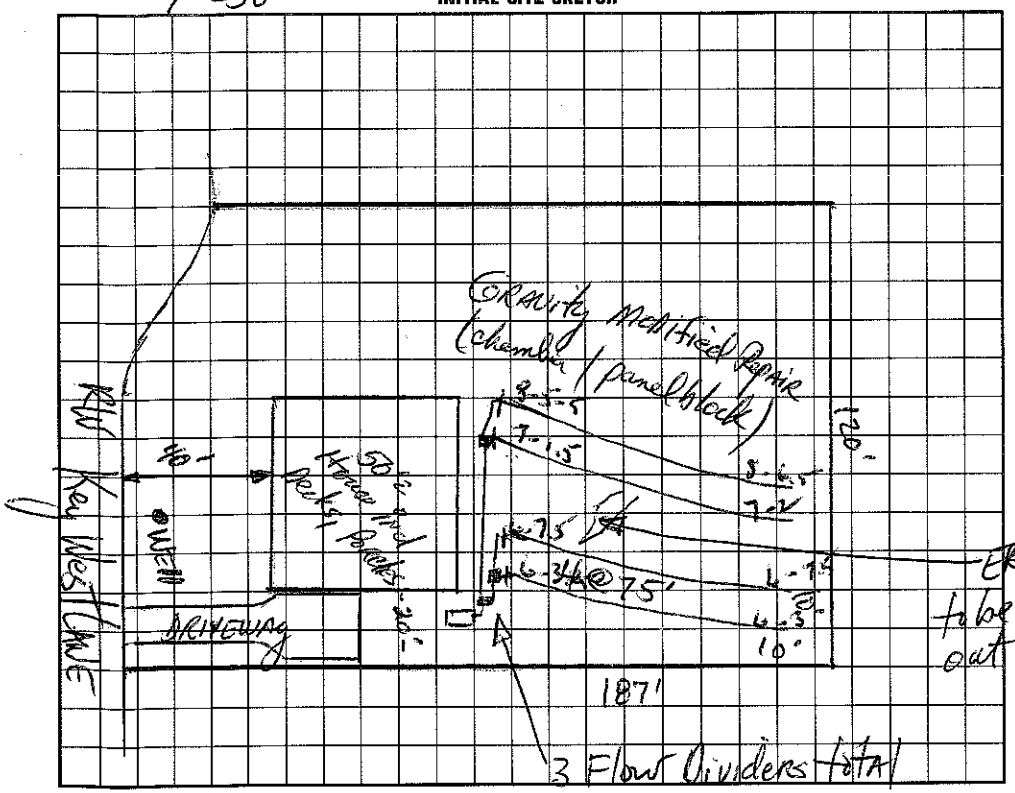

AS BUILT SKETCH

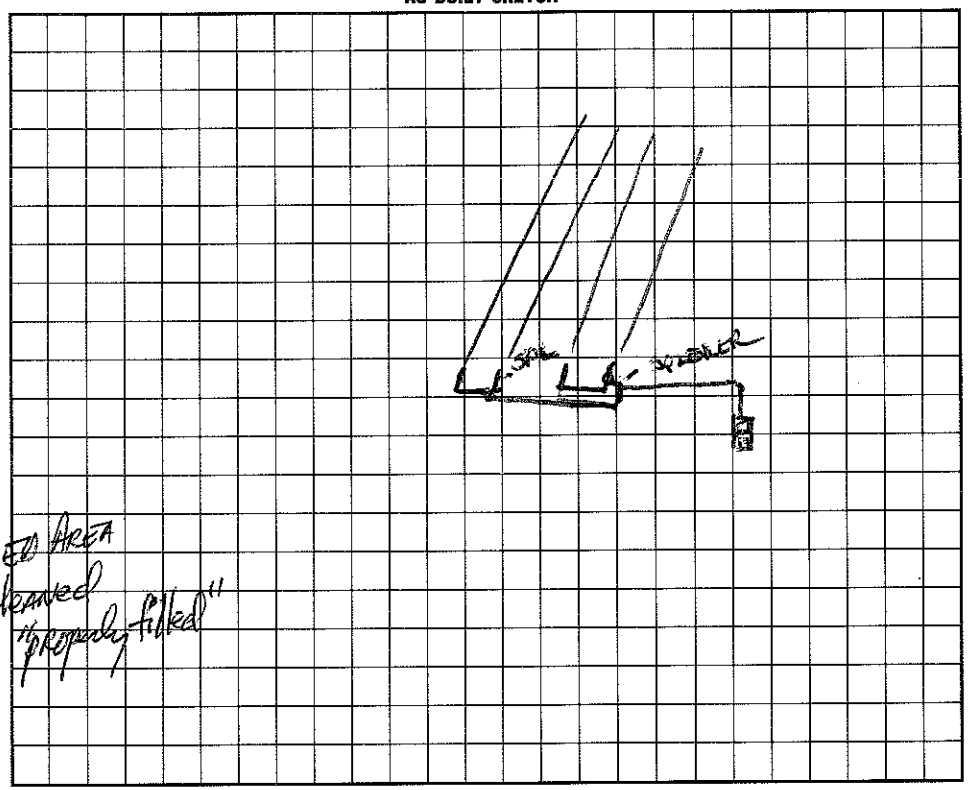

I understand that this permit can be suspended or revoked if any false information is supplied toward securing the permit/any unauthorized changes are made to the site/any unauthorized changes are made in the installation of the system. Improvement Permit is valid for 60 months from date of issuance.

Signed: X

Improvement Permit by: David R. Hunter RS date 2-4-97

~~Existing System Inspection by:~~ Construction Authorization D R Hunter RS date 2-4-97

Installed by: B+M Enterprises

Certificate of Completion by: Wesley Sparks RS date 5/20/97

Operation Permit by: Wesley Sparks RS. date 5/20/97

HEALTH DEPT. COPY: WHITE INSPECTION COPY (FINAL): GREEN OWNER COPY (FINAL): YELLOW INSPECTION COPY (INITIAL): PINK OWNER COPY (INITIAL): GOLD