4659 167858

IREDELL COUNTY HEALTH DEPARTMENT Const. Auth. - STATESVILLE 704-878-5305 MOORESVILLE 704-664-5281

IMPROVEMENT PERMIT / ~~CERTIFICATE OF COMPLETION~~ / OPERATION PERMIT / EXISTING SYSTEM INSPECTION

PROPERTY DESCRIPTION NO. 24925 DATE April 19, 97 TAX MAP NO. part of 4EA12 Watershed: ☑ Yes ☐ No

OWNER OR CONTRACTOR Fourth Nov. Co PHONE: Business _____ Home _____

ADDRESS 142 Statta Rd, Mooresville

LOCATION 21 N. to Sailwinds TL Key West Lane

SUBDIVISION Windward Pt BLOCK / SECTION _____ LOT 76 LOT AREA .5 Ac SITE CLASS. B DESIGN FLOW 360 gpd L.T.A.R. .13

Septic Tank: 1000 Gallons; STB 1012 Date 3.12.98

Pump Tank: _____ Gallons; PT _____ Date _____

Pump Make: _____ Model _____ Serial No. _____

Nitrification Field: No Fields 1 Square Feet 900 Linear Feet 300

No Lines 4@75' Trench Width 36" Max Trench Bottom Depth 36" Gravel Depth N/A

☑ New System ☐ Repair System Type: I, II, III, IV, V, VI

System Description: gravity chambered

Repair System Description: same

Maintenance Agreement Required: ☐ Yes ☑ No

☐ House/Mod. Home No. Bedrooms 3

☑ Mobile Home No. Bathrooms 2

☐ Business No. Employees _____

☐ Other _____

Water Supply: ☑ Individual ☐ Community ☐ Public

☐ Slab ☑ Crawl Space ☐ Basement w/plumbing ☐ Basement wo/plumbing


Comments:

Install an inspection port per chambered lateral created ~ 3/4 way down length of trench

Comments:

INITIAL SITE SKETCH

1"=50'

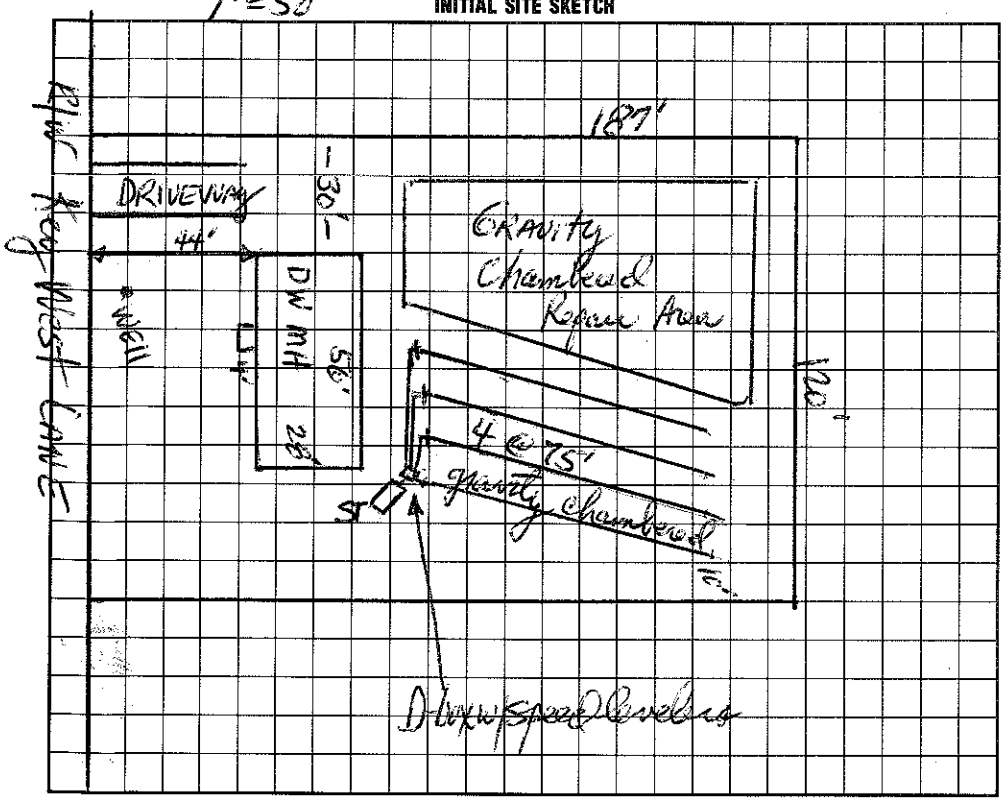

AS BUILT SKETCH

I understand that this permit can be suspended or revoked if any false information is supplied toward securing the permit/any unauthorized changes are made to the site/any unauthorized changes are made in the installation of the system. Improvement Permit is valid for 60 months from date of issuance.

Signed: _____

Improvement Permit by: D.R. Hanson RS date 4/19/97

~~Construction Authorization~~ by: D.R. Hanson RS date 4/19/97

Installed by: A-1 Backhoe

Certificate of Completion by: Wesley Sparks RS. date 5/13/98

Operation Permit by: Wesley Sparks RS. date 5/13/98

HEALTH DEPT. COPY: WHITE INSPECTION COPY (FINAL): GREEN OWNER COPY (FINAL): YELLOW INSPECTION COPY (INITIAL): PINK OWNER COPY (INITIAL): GOLD