Rec'd 10-14-14

IREDELL COUNTY HEALTH DEPARTMENT

ENVIRONMENTAL HEALTH DIVISION

PAGE 1: *APPLICATION FORM*

Application For: ( ) New Well Permit ( ) Well Repair Permit ( ) Well Abandonment
( ) Septic Improvement Permit (✓) Authorization to Construct ( ) Existing System Inspection ( ) Septic System Repair

THE ABOVE PERMIT DOCUMENTS WILL BECOME INVALID IF INFORMATION PROVIDED ON THIS APPLICATION IS FALSIFIED OR CHANGED, OR IF THE SITE IS ALTERED. THE IMPROVEMENT PERMIT IS VALID FOR EITHER 60 MONTHS OR WITHOUT EXPIRATION DEPENDING UPON DOCUMENTATION SUBMITTED APPLICATION WITH SITE PLAN 60 MONTHS, APPLICATION WITH COMPLETE, SCALED PLAT WITHOUT EXPIRATION. SEE 15A NCAC 18A .1937(f) FOR DETAILS.

Page 2: *Site Plan Worksheet* form MUST accompany this application

The following optional attachments may also be submitted: (✓) Survey Plat, scaled no more than 1 inch = 60 feet
Place an (X) beside whichever is submitted if applicable (✓) Custom Site Plan, scaled no more than 1 inch = 60 feet

Applicant Information:

Applicant Name: ESSEX HOMES Address: 13000 S. TRYON ST, F205 CHARLOTTE, NC 28278 OFFICE - Phone: 7044238988

Owner Name: " " Address: " " CELL - Phone: 704 622 5152

Property Information:

Street Address: 115 CLEARSPRINGS LN. MOORESVILLE, NC 28115

Subdivision Name: AUTUMN GROVE Section/Phase: 2 Lot Number: 21

Driving Directions: CHARLOTTE HIGHWAY WEST, LEFT ON CLEAR SPRINGS LN. PROPERTY IS ON THE LEFT AT THE CORNER.

Site Development Information: *(check or complete ALL that apply)*

(✓) New Single Family Residence
( ) New Multi-Family Residence
( ) Accessory Building
( ) Bedroom(s) Addition

Maximum Number of Bedrooms: 4
Maximum Number of Occupants: 8
( ) Swimming Pool
( ) Other Addition/Structure: _____

( ) Crawl Space Foundation
(✓) Concrete Slab Foundation
( ) Basement with Plumbing
( ) Basement without Plumbing

Non-Residential Site Development:
Type of Business: _____
Square Footage of Building: _____
Maximum Number of Employee: _____
Maximum Number of Seats/Beds/Other: _____

Water Supply:

(✓) New Well ( ) Existing Well ( ) Community Well ( ) City Water ( ) Other Public Water

Desired Septic System Type: *(you may rank in order of preference)* Year existing system installed: _____
( ) No Preference ( ) Alternative ( ) Conventional (✓) Innovative ( ) Modified Conventional ( ) Other: _____

Please answer the following to the best of your ability:

( ) Yes (✓) No Does the site contain any jurisdictional wetlands?
( ) Yes (✓) No Is any non-domestic sewage (i.e. industrial) to be generated?
( ) Yes (✓) No Is the site subject to approval by any other public agency?

I have read this application and certify that the information provided herein is true, complete, and correct. Authorized county and state officials are granted right of entry to conduct necessary inspections to determine compliance with applicable laws and rules. I understand that I am solely responsible for the proper identification and labeling of all property lines and corners and making the site accessible so that a complete site evaluation can be performed.

Signature: _____ 10-14-14
Property owner or owner's legal representative signature (SIGNATURE REQUIRED) DATE

IREDELL COUNTY HEALTH DEPARTMENT


ENVIRONMENTAL HEALTH DIVISION

PAGE 2: ***SITE PLAN WORKSHEET***

SEE THE "SAMPLE SITE PLAN" BELOW. ***INCOMPLETE SITE PLANS WILL BE RETURNED TO YOU FOR COMPLETION AND MAY RESULT IN A DELAY IN THE ISSUANCE OF YOUR SEPTIC SYSTEM PERMIT!!!***

Place an (X) beside each item as you complete the site plan:

- (✓) Property Line measurements are clearly identified
- (✓) All proposed structures are indicated
- (✓) Front and side setbacks from property line
- (✓) Preferred driveway location and well location
- (✓) Area you prefer your septic system to be placed
- (✓) North arrow, or other sufficient indicator of direction

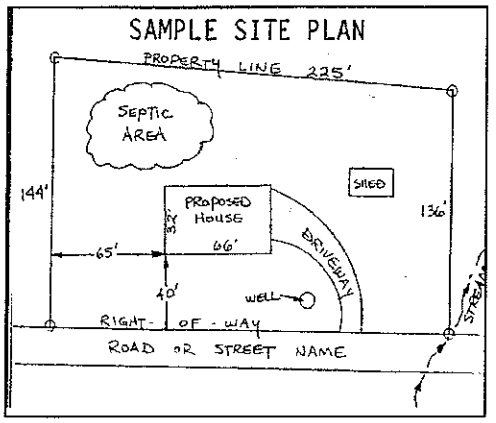

Circle N/A on the following if appropriate:

Location of septic systems and wells within 100' of your property	N/A
Location of easements and rights of ways on your property	N/A
Location of any designated wetlands on the property	N/A

USE THIS SPACE TO DRAW YOUR SITE PLAN

Show: proposed house or business footprint, wells, water lines, patios, pools and decks, and any other item that will occupy space on the site


☑ PLEASE SEE ENCLOSED PLOT PLAN AND IMPROVEMENT PERMIT.

Signature: _____

Property owner or owner's legal representative signature (SIGNATURE REQUIRED)

10-14-14

DATE

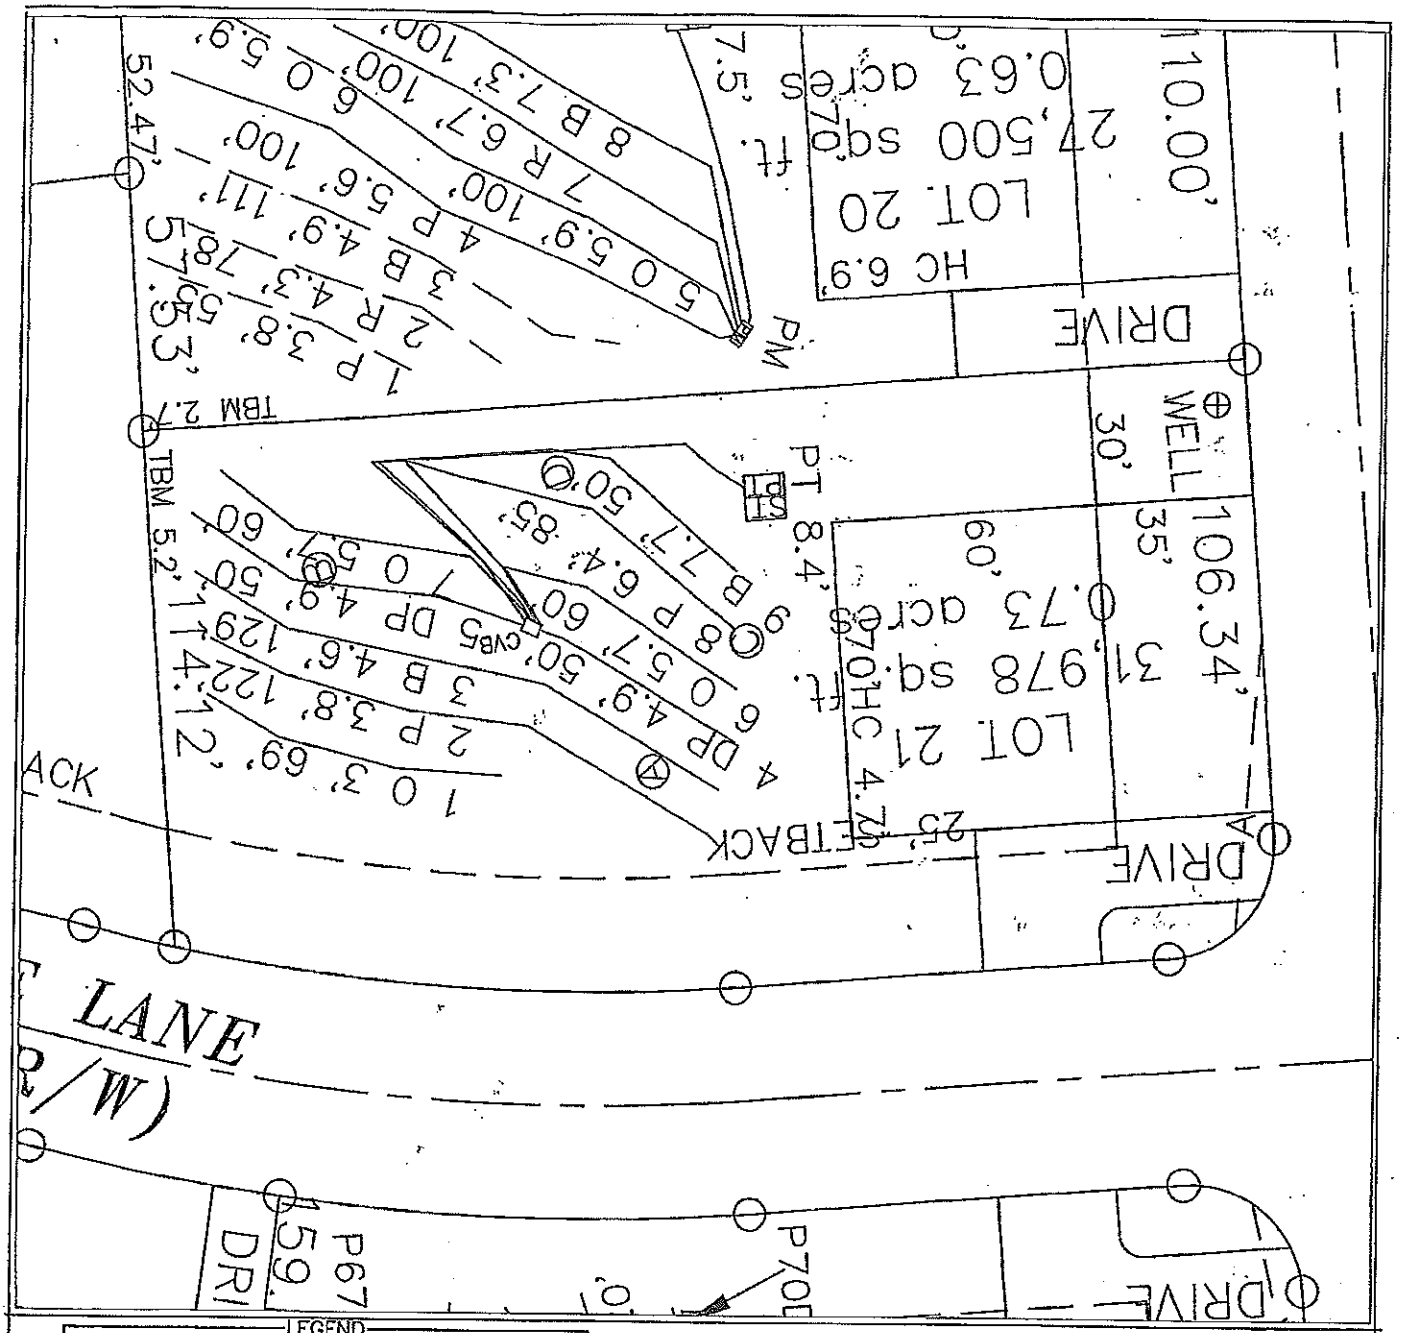

LEGEND

House Box.

System lines.

Repair lines.

GRAPHIC SCALE
1" = 40'

40 0 40 80

FOR PRELIMINARY PLANNING PURPOSES ONLY. ALL LOTS WILL REQUIRE FINAL APPROVAL BY THE COUNTY HEALTH DEPARTMENT ON A LOT BY LOT BASIS. THIS MAP SHOULD BY USED AS A GENERAL GUIDE, SOME ADJUSTMENTS WILL BE NECESSARY IN THE FIELD DUE TO SOIL VARIABILITY AND COMPLEX TOPOGRAPHIC FEATURES. THIS MAP ONLY REFLECTS EXISTING SOIL SUITABILITY FOR ON-SITE SEPTIC TANK SYSTEMS.

PLEASE REFER TO ATTACHED SOIL REPORT FOR ADDITIONAL SITE SPECIFIC INFORMATION


ROLLANS SOIL & ENVIRONMENTAL SERVICES
470 NORTH BROAD STREET SUITE D
MOORESVILLE, NC 28115
PHONE: (704) 658-1723
FAX: (704) 658-1724
BRADY FREEMAN B.S.
MOBILE: (704) 746-1687
EMAIL: BFREEMAN@ROLLANSENVIRONMENTAL.COM
ASHLEY ROLLANS, NC LICENSED SOIL SCIENTIST
MOBILE: (704) 791-3018
EMAIL: AROLLANS@ROLLANSENVIRONMENTAL.COM

MAP TITLE: SITE PLAN & DRAINFIELD AREAS

PROJECT NAME: L&J DEVELOPMENT/AUTUMN GROVE SUBDIVISION



JOB # : 01-1043
FILE: C:\JOBS\01-1043
PROJECT MGR.: C.B.F.
FIELD WORK: C.B.F., A.L.P. & M.D.B.
DRAWN BY: C.B.F. & M.D.B.

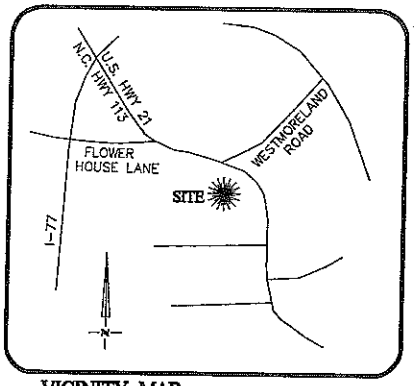


VICINITY MAP
Not To Scale

REVISIONS

REV. #	DATE	COMMENT
REV. 1	9/29/14	ADDED SPETIC FIELD

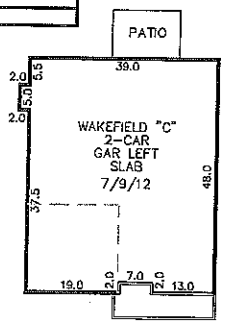

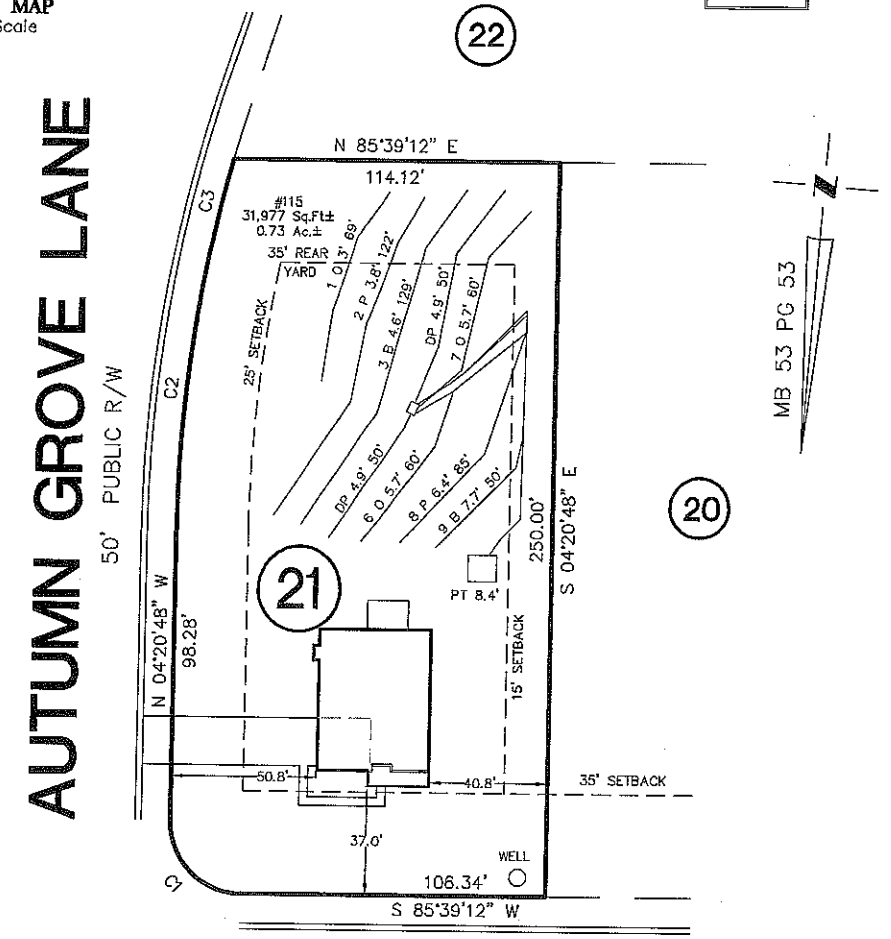

CLEAR SPRINGS ROAD

50' PUBLIC R/W

CURVE TABLE				
CURVE	BEARING	CHORD	LENGTH	RADIUS
C1	N49°20'48"W	35.36	39.28	25.00
C2	N01°31'04"E	97.06	97.23	475.00
C3	N09°15'15"E	31.03	31.04	475.00

NOTE:
1. BUILDER ASSUMES RESPONSIBILITY FOR GRADING LOT AND/OR DESIGNING STEPS, PORCHES, DECKS, ETC. AS NECESSARY TO PREVENT ENCROACHMENT INTO SETBACKS.
2. HOUSE DIMENSIONS AND OPTIONS SHOULD BE VERIFIED WITH CONTRACTOR PRIOR TO CONSTRUCTION.
3. SETBACKS/ EASEMENTS SHOULD BE VERIFIED WITH DEVELOPER AND LOCAL OFFICIALS PRIOR TO CONSTRUCTION.
4. THIS IS A CONCEPTUAL DRAWING AND CONTENTS SHOWN HEREON ARE SUBJECT TO CHANGE UPON FINAL CONSTRUCTION.
THIS PROPERTY MAY BE SUBJECT TO ANY AND ALL APPLICABLE DEED RESTRICTIONS, EASEMENTS, RIGHT-OF-WAY, UTILITIES AND RESTRICTIVE COVENANTS WHICH MAY BE OF RECORD OR IMPLIED

THIS DRAWING DOES NOT REFLECT AS-BUILT INFORMATION

PRELIMINARY PLAT
NOT FOR RECORDATION, CONVEYANCES, OR SALES.

50 0 50
SCALE: 1" = 50'

HOUSE LOCATION PLOT PLAN

FOR

LOT 21, AUTUMN GROVE SUBDIVISION, PHASE 2
Barringer Township, Iredell County, North Carolina

PROPERTY OF: ESSEX HOMES

MAP BOOK 53 PAGE 53 DEED REFERENCE

DRAWN BY: ERG | DATE: SEPTEMBER 24, 2014

EASTOVER
LAND SURVEYING COMPANY, P.A.
LAND SURVEYORS - PLANNERS
600 TOWNE CENTRE BOULEVARD, SUITE #309
PINEVILLE, NORTH CAROLINA 28134
PHONE (704) 927-8080
FAX (704) 889-0105

IREDELL COUNTY HEALTH DEPARTMENT

Application For Improvement Permit and/or Authorization To Construct, Existing System Inspection

(THE ABOVE PERMIT DOCUMENTS WILL BECOME INVALID IF INFORMATION PROVIDED ON THIS APPLICATION IS FALSIFIED OR CHANGED, OR IF THE SITE IS ALTERED. THE IMPROVEMENT PERMIT IS VALID FOR EITHER 60 MONTHS OR WITHOUT EXPIRATION DEPENDING UPON DOCUMENTATION SUBMITTED - APPLICATION WITH SITE PLAN 60 MONTHS, APPLICATION WITH COMPLETE, SCALED PLAT WITHOUT EXPIRATION. SEE 15A NCAC 18A .1937(f) FOR DETAILS)

1. APPLICATION FOR: ✓ Improvement Permit ___Authorization To Construct ___BOTH ___Existing System Inspection

2. Page 2: *Site Plan Worksheet* Form MUST Accompany This Application
   The following optional attachments may also be submitted: ___ Survey Plat, Scaled no more than 1 Inch = 60 Feet
   Place check ( ) beside whichever is submitted if applicable ___ Custom Site Plan, Scaled no more than 1 Inch = 60 Feet

3. **Applicant Information:**

Applicant Name	Mailing Address	Home Phone	Work Phone
E & J Developemnt Co.	P.O Box 1066 Huntersville NC 28070	(704)-201-6465	Same
Owner Name	Mailing Address	Home Phone	Work Phone

4. **Property Information:**

Street Address	Subdivision Name	Section/Phase and Lot Number
	Autumn Grove	21

Driving Directions: See Zoning Permit

****

5. **RESIDENTIAL Site Development Information:** *(Check or Complete ALL that apply)*

( ) New, Single Family Residence
( ) New, Multi-Family Residence
( ) Expansion of Existing Septic System
( ) Repair To Failing Septic System

Maximum Number of Bedrooms 4
Maximum Number of Occupants 8
If Expansion, Current Number of Bedrooms ___

( ) Crawl Space Foundation?
( ) Concrete Slab Foundation?
( ) Basement w/Plumbing?
( ) Basement w/out Plumbing?

IF Non- Residential Site Development:
Type of Business ___
Square Footage of Building ___
Maximum Number of Employees ___
Maximum Number of Seats ___

****

6. **Proposed Water Supply:**

(✓) New Well ( ) Existing Well ( ) Community Well ( ) City Water ( ) Other Public Water

****

7. **Desired Septic System Type:** *(You may rank in order of preference, if any)*

( ) Alternative ( ) Conventional ( ) Innovative ( ) Modified Conventional ( ) Other___ (✓) No Preference

****

8. **Please Answer The Following To The Best of Your Ability:**

( ) Yes (✓) No Does the site contain any jurisdictional wetlands?
( ) Yes (✓) No Is any non-domestic sewage (i.e. industry) to be generated?
( ) Yes (✓) No Is the site subject to approval by any other public agency?

****

I have read this application and certify that the information provided herein is true, complete, and correct. Authorized county and state officials are granted right of entry to conduct necessary inspections to determine compliance with applicable laws and rules. I understand that I am solely responsible for the proper identification and labeling of all property lines and corners and making the site accessible so that a complete site evaluation can be performed.

9. Signature: Chad N. Wagner — 7/9/07

Property owner or owner's legal representative signature (SIGNATURE REQUIRED) — DATE

IREDELL COUNTY HEATLH DEPARTMENT

PAGE 2: *SITE PLAN WORKSHEET*

SEE THE SAMPLE SITE PLAN BELOW. INCOMPLETE SITE PLANS WILL BE RETURNED TO YOU FOR COMPLETION AND MAY RESULT IN A DELAY IN THE ISSUANCE OF YOUR SEPTIC SYSTEM PERMIT!!!

Place an (X) beside each item as you complete the site plan:

- ✓ **Property Line measurements are clearly identified…**
- ✓ **All proposed structures are indicated…**
  SHOW: proposed house or business footprint, wells, water lines, patios, pools and decks, and any other item that will occupy space on the site
- ✓ **Front and side setbacks from property line…**
- ✓ **Preferred driveway location and configuration, preferred well location…**
- ✓ **Area you prefer your septic system to be placed…**
- ✓ **North arrow, or other sufficient indicator of direction…**

Circle N/A on the following if appropriate:

- ____ **Location of septic systems and wells within 100' of your property…** N/A
- ____ **Location of easements and rights of ways on your property…** N/A
- ____ **Location of any designated wetlands on the property…** N/A

Signature: Chad M. Wagner
Property owner or owner's legal representative signature (SIGNATURE REQUIRED)

7/9/07
DATE

USE THIS SPACE TO DRAW YOUR SITE PLAN

See Attached Site Plan.

