IREDELL COUNTY HEALTH DEPARTMENT

STATESVILLE 704-878-5305 MOORESVILLE 704-664-5281

IMPROVEMENT PERMIT / AUTHORIZATION TO CONSTRUCT / OPERATION PERMIT / EXISTING SYSTEM INSPECTION

PERMIT# 25011 PIN# 4EA12 4659 16 9970 DATE 4/15/98

OWNER OR CONTRACTOR Pruitt Dev. Co. PHONE: Business 875-0081 Home

ADDRESS 13420 Reese Blvd. W Huntersville NC. 28078

LOCATION 115-21 N. TR Sandusinda Rd. TL Key West Loop to 6th lot on (L)

SUBDIVISION Winward Point BLOCK / SECTION LOT 83 LOT AREA .54 Ac SITE CLASS. RS DESIGN FLOW 360 L.T.A.R. .3

Septic Tank: 1000 Gallons; STB 1012 Date 5/1/98
Pump Tank: 1000 Gallons; PT Date
Pump Make: Model Serial No.
Nitrification Field: No Fields 1 Square Feet * 900 Linear Feet * 300
No Lines 4 Trench Width 36 Max Trench Bottom Depth 36 Gravel Depth SAND.

☑ New System ☐ Repair System Type: I, II, (III), IV, V, VI
System Description: ~~Conv.~~ Ch. Plastic
Repair System Description: Same
Maintenance Agreement Required: ☐ Yes ☑ No


☑ House/Mod. Home No. Bedrooms 3
☐ Mobile Home No. Bathrooms 2
☐ Business No. Employees
☐ Other
☐ Slab ☐ Crawl Space ☐ Basement w/plumbing ☐ Basement wo/plumbing

Water Supply: ☑ Individual ☐ Public ☐ Community


Comments:/Conditions: * 25% reduction for Ch. Plastic use

Comments:/Conditions:

INITIAL SITE SKETCH

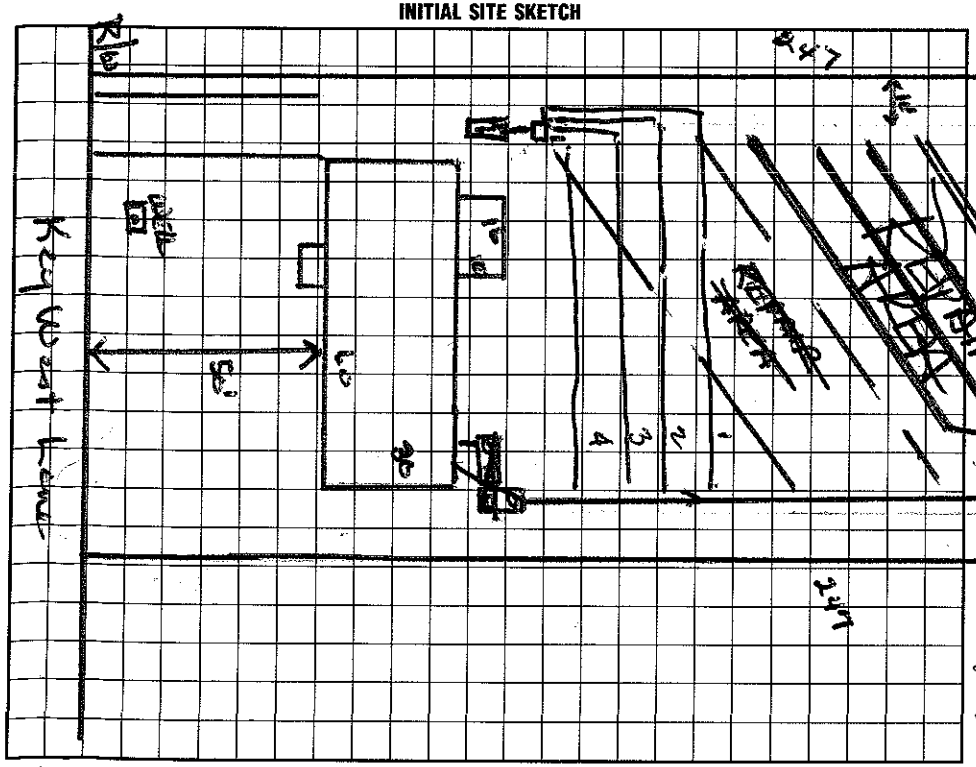

AS BUILT SKETCH

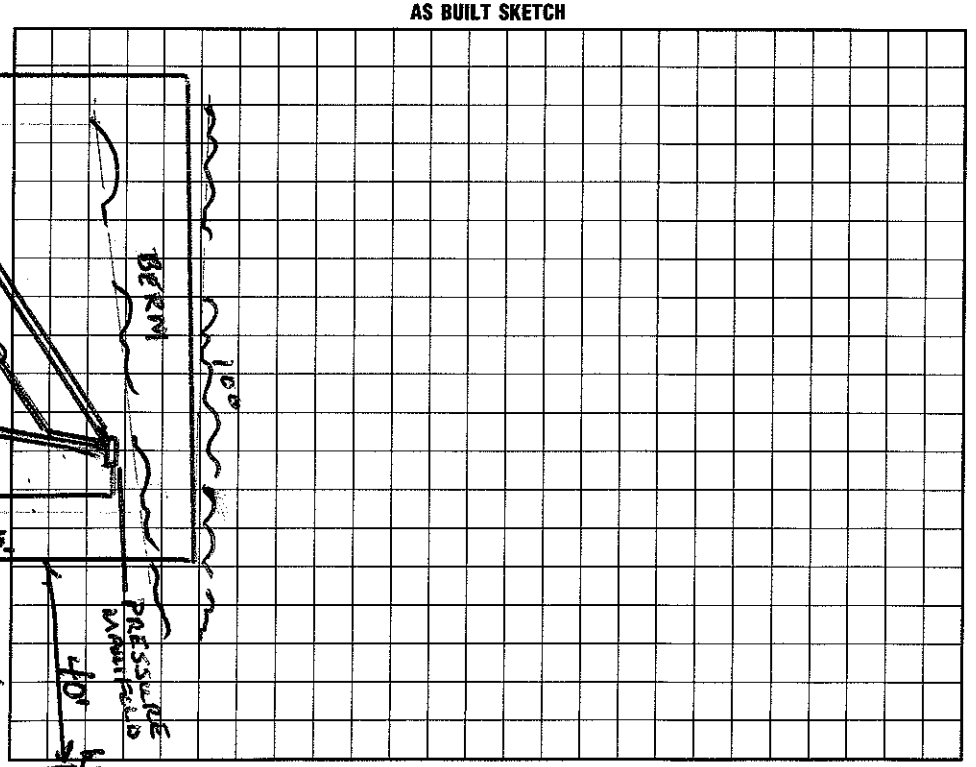

I understand that this permit can be suspended or revoked if any false information is supplied toward securing the permit, any unauthorized changes are made to the site/any unauthorized changes are made in the installation of the system. Improvement Permit with plat valid without expiration. Improvement Permit with site plan valid for sixty months. Authorization to Construct is valid for a period equal to that of Improvement Permit – not to exceed sixty months.

Signed: * date 4-28-98 Installed by: Al Backhoe

Improvement Permit by: Wesley Sparks RS. date 4/15/98 Operation Permit by: Wesley Sparks RS date 7/6/98

Authorization to Construct by: Wesley Sparks RS. date 4/15/98 Existing System Inspection by: Wesley Sparks RS date 7/6/98

HEALTH DEPT. COPY: WHITE INSPECTION COPY (FINAL): GREEN OWNER COPY (FINAL): YELLOW INSPECTION COPY (INITIAL): PINK OWNER COPY (INITIAL): GOLD