4659170080

Cons 4th.

IREDELL COUNTY HEALTH DEPARTMENT

STATESVILLE 704-878-5305 MOORESVILLE 704-664-5281

IMPROVEMENT PERMIT / ~~CERTIFICATE OF COMPLETION~~ / OPERATION PERMIT / EXISTING SYSTEM INSPECTION

PROPERTY DESCRIPTION NO. 24903 DATE 6-11-97 TAX MAP NO. pt. of 4EA12

OWNER OR CONTRACTOR Pruitt Dev. Co.

ADDRESS 142 Stutts Rd. Mooresville, NC PHONE: Business ______ Home ______ Watershed: ☒ Yes ☐ No

LOCATION 21 N. TL Sailwinds TL Whitewater Ln 3rd on left

SUBDIVISION Windward Pt. BLOCK / SECTION ______ LOT 54 LOT AREA .5 Acre SITE CLASS. PS. DESIGN FLOW 360 gpd L.T.A.R. .3

Septic Tank: 1000 Gallons; STB 1012 Date 4/14/97

Pump Tank: ______ Gallons; PT ______ Date ______

Pump Make: ______ Model ______ Serial No. ______

Nitrification Field: No Fields 1 Square Feet 900 Linear Feet 300

No Lines 4 at 75' Trench Width 36" Max Trench Bottom Depth 36" Gravel Depth N/A

☒ New System ☐ Repair System Type: I, II, (III), IV, V, VI

System Description: Gravity Plastic Chamber

Repair System Description: Modified

Maintenance Agreement Required: ☐ Yes ☒ No

☐ House/Mod. Home ☒ Mobile Home ☐ Business ☐ Other ______

No. Bedrooms 3 No. Bathrooms 2 No. Employees ______


Water Supply: ☒ Individual ☐ Community ☐ Public

☐ Slab ☒ Crawl Space ☐ Basement w/plumbing ☐ Basement wo/plumbing

Comments: Install inspection ports near end of Each lateral

Comments:

Scale 1:50 **INITIAL SITE SKETCH**

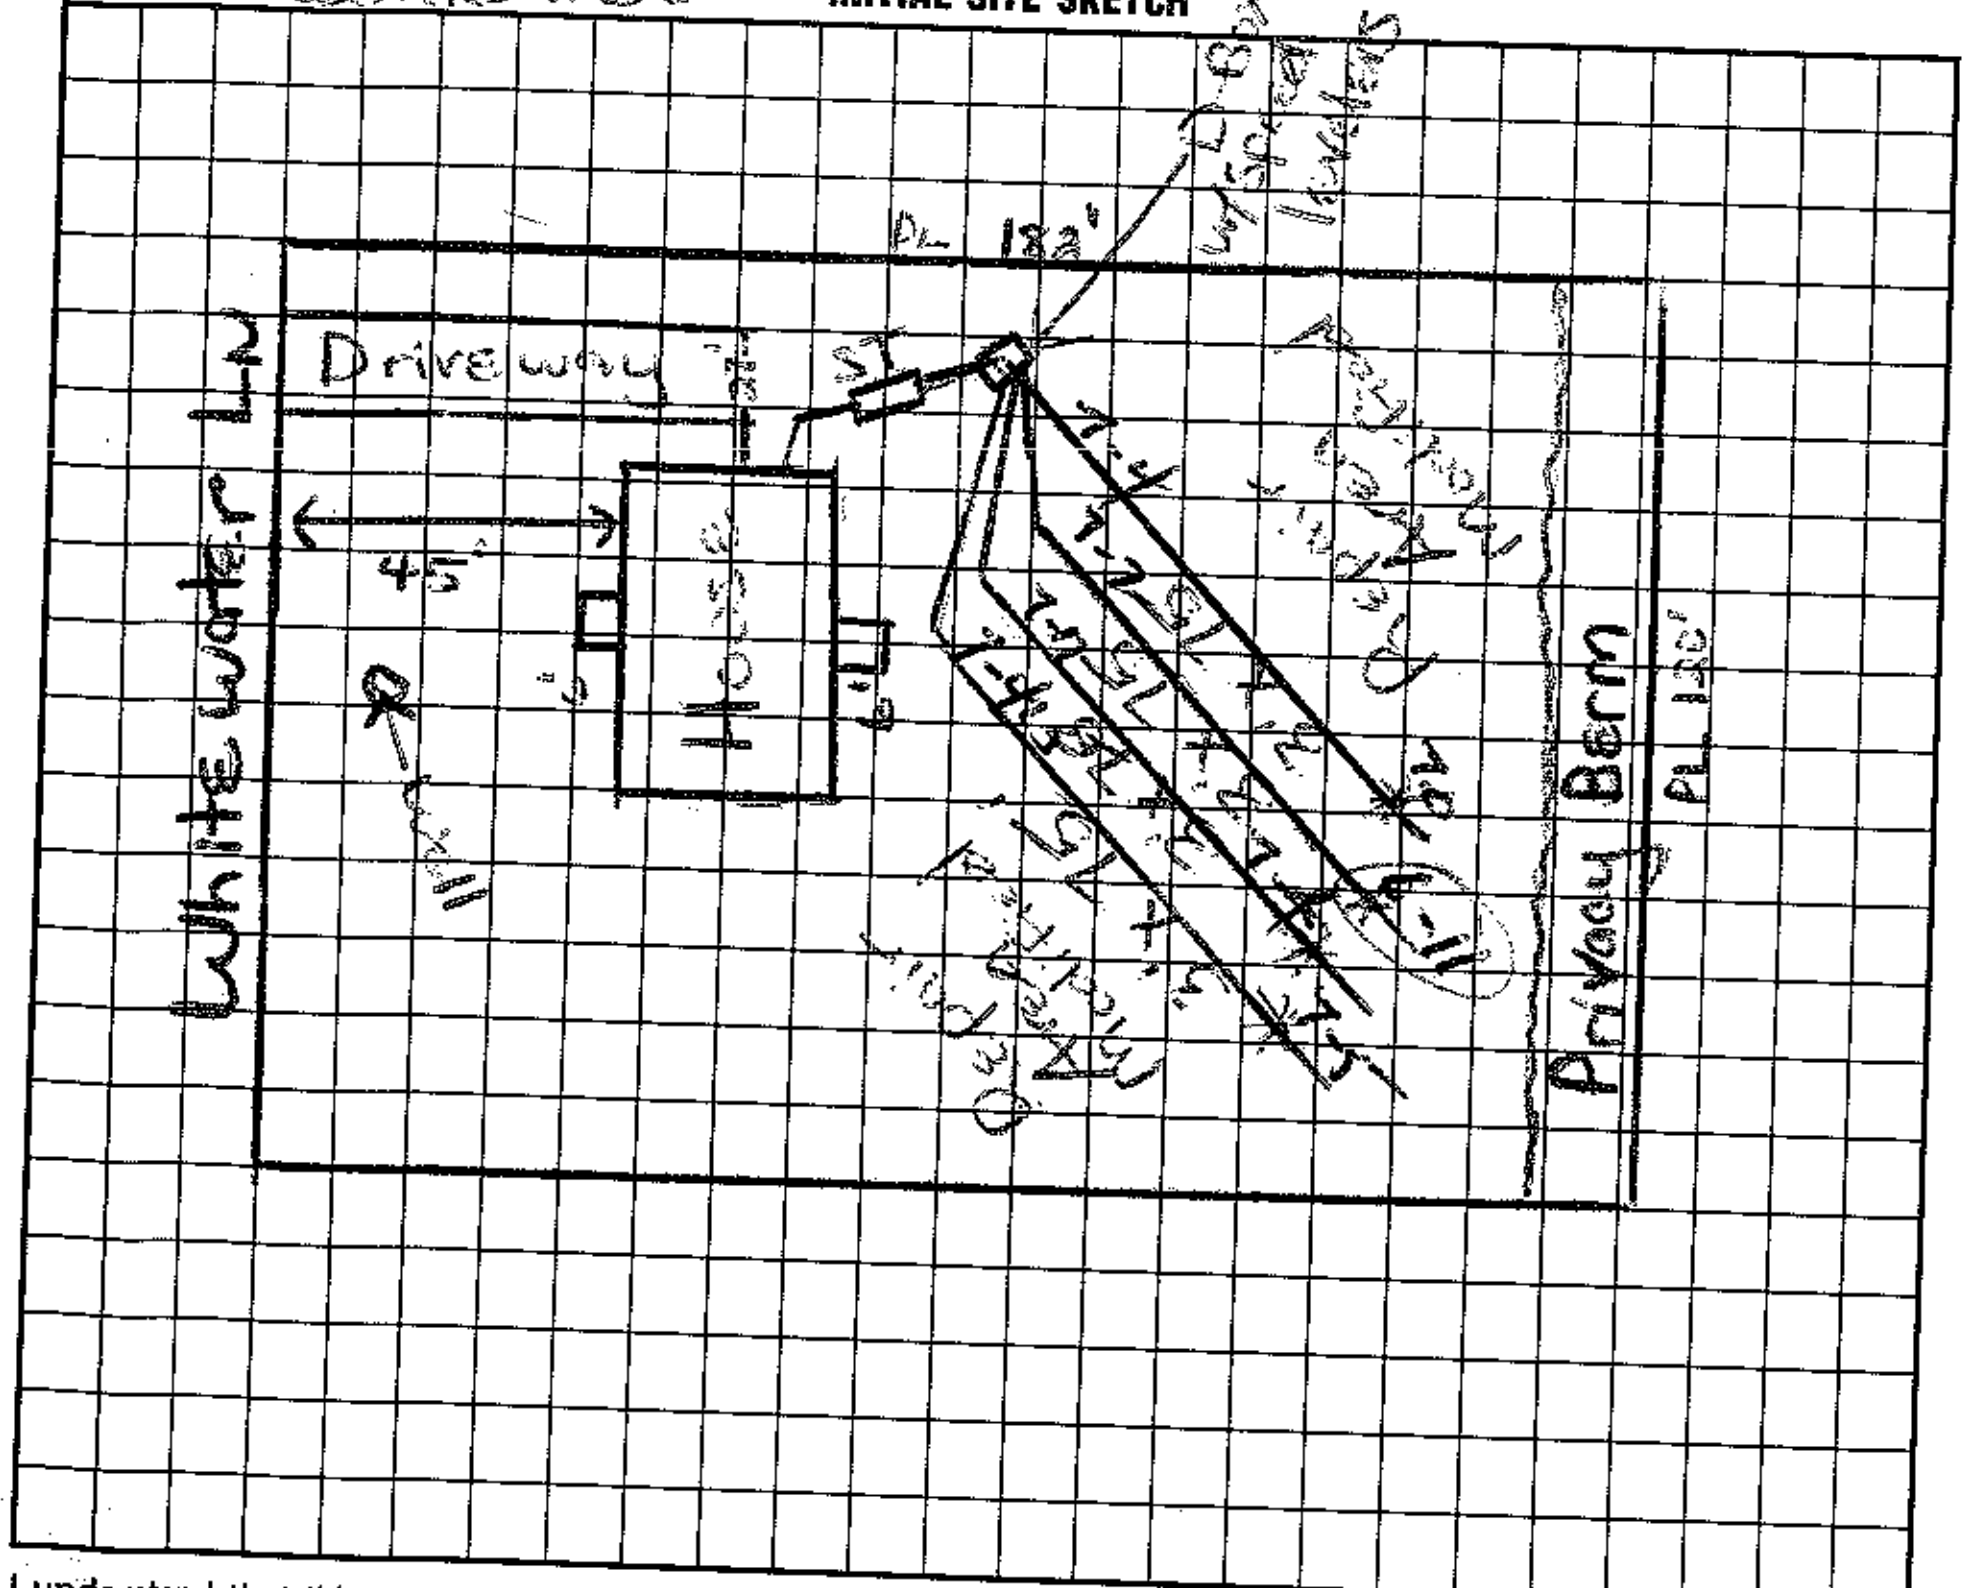

AS BUILT SKETCH

I understand that this permit can be suspended or revoked if any false information is supplied toward securing the permit/any unauthorized changes are made to the site/any unauthorized changes are made in the installation of the system. Improvement Permit is valid for 60 months from date of issuance.

Signed: Russell Olson

Improvement Permit by: Maria H.H. Dotson date 6/11/97

~~Existing System Inspection~~ by: Maria H.H. Dotson date 6/11/97

Installed by: A-1 Backhoe Service

Certificate of Completion by: Wesley Sparks R.S. date 6/16/97

Operation Permit by: Wesley Sparks RS date 6/16/97

Construction Auth.

HEALTH DEPT. COPY: WHITE INSPECTION COPY (FINAL): GREEN OWNER COPY (FINAL): YELLOW INSPECTION COPY (INITIAL): PINK OWNER COPY (INITIAL): GOLD