4659170162 (3100)

IREDELL COUNTY HEALTH DEPARTMENT

STATESVILLE 704-878-5305 MOORESVILLE 704-664-5281

IMPROVEMENT PERMIT / CERTIFICATE OF COMPLETION / OPERATION PERMIT / EXISTING SYSTEM INSPECTION

PROPERTY DESCRIPTION NO. 24904 DATE 2-6-97 TAX MAP NO. 4E A 12 Watershed: ☑ Yes ☐ No

OWNER OR CONTRACTOR Pruitt Development PHONE: Business 875 8001 Home WS IV CA

ADDRESS 290 Lake View Dr. Mooresville

LOCATION US 21 Turn Sailwinds TL Whitewater 2nd lot left

SUBDIVISION Windward Pt. BLOCK / SECTION ____ LOT 55 LOT AREA 21780 SITE CLASS. PS DESIGN FLOW 360 L.T.A.R. .3

Septic Tank: 1000 Gallons; STB 794 Date 2/7/97

Pump Tank: ____ Gallons; PT ____ Date ____

Pump Make: ____ Model ____ Serial No. ____

Nitrification Field: No Fields 1 Square Feet 900 Linear Feet 300

No Lines 3 Trench Width 36" Max Trench Bottom Depth 36" Gravel Depth N/A

☐ New System ☐ Repair System Type: I, II, III, IV, V, VI

System Description: Gravity Chambers

Repair System Description: Pump To Chambers

Maintenance Agreement Required: ☐ Yes ☐ No

☐ House/Mod. Home No. Bedrooms 3

☐ Mobile Home No. Bathrooms 2

☐ Business No. Employees ____

☐ Other ____


☐ Slab ☐ Crawl Space ☐ Basement w/plumbing ☐ Basement wo/plumbing

Water Supply: ☑ Individual ☐ Community ☐ Public

Comments: 77 67 73

Comments:

INITIAL SITE SKETCH 182'

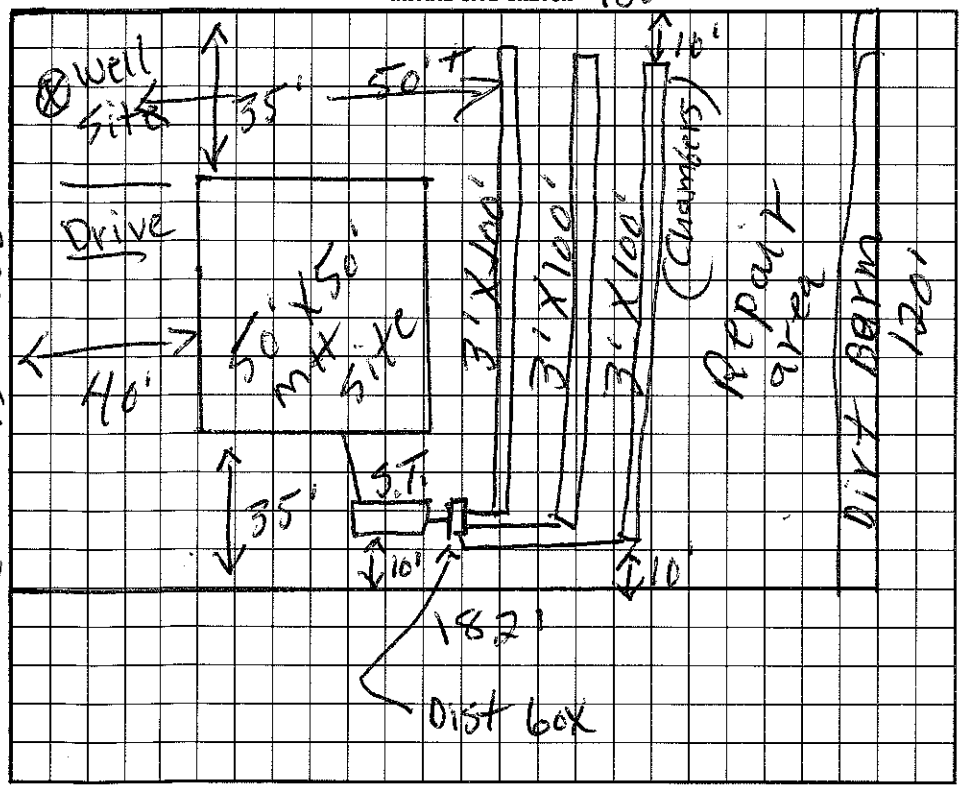

AS BUILT SKETCH

SAME AS SITE SKETCH

I understand that this permit can be suspended or revoked if any false information is supplied toward securing the permit/any unauthorized changes are made to the site/any unauthorized changes are made in the installation of the system. Improvement Permit is valid for 60 months from date of issuance.

Signed: ____

Improvement Permit by: E. C. Moore date 2-6-97

Authorization to Existing System Inspection by: E. C. Moore date 2-6-97

Installed by: TIM AMMONS

Certificate of Completion by: ____ date ____

Operation Permit by: C. [illegible] date 4/25/97

HEALTH DEPT. COPY: WHITE INSPECTION COPY (FINAL): GREEN OWNER COPY (FINAL): YELLOW INSPECTION COPY (INITIAL): PINK OWNER COPY (INITIAL): GOLD

Authorization to Const. EXPIRES 60 MOS FROM ISSUE