4059170234

IREDELL COUNTY HEALTH DEPARTMENT Const. Auth

STATESVILLE 704-878-5305 MOORESVILLE 704-664-5281

IMPROVEMENT PERMIT / ~~CERTIFICATE OF COMPLETION~~ / OPERATION PERMIT / EXISTING SYSTEM INSPECT

PROPERTY DESCRIPTION NO. 24905 DATE June 2, '97 TAX MAP NO. part of 4CH12 Watershed: ☐ Yes

OWNER OR CONTRACTOR Pruett Dev. Co. PHONE: Business Home

ADDRESS 142 Statts Rd, Mooresville

LOCATION 145-21 N to Sailwinds TL Whitewater 1st lot on left - corner lot

SUBDIVISION Windward Point BLOCK / SECTION LOT 56 LOT AREA 120' x 182' SITE CLASS. PS DESIGN FLOW 360gpd L.T.A.R. .13

Septic Tank: 1000 Gallons; STB 794 Date 12/5/98

Pump Tank: Gallons; PT Date

Pump Make: Model Serial No.

Nitrification Field: No Fields 1 Square Feet 900 Linear Feet 300

No Lines 3@100' Trench Width 36" Max Trench Bottom Depth 36" Gravel Depth N/A

☑ New System ☐ Repair System Type: I, II, III, IV, V, VI

System Description: gravity chambered

Repair System Description: pumped chambered

Maintenance Agreement Required: ☐ Yes ☒ No

☑ House/Mod. Home No. Bedrooms 3

☐ Mobile Home No. Bathrooms 2

☐ Business No. Employees

☐ Other


☐ Slab ☑ Crawl Space ☐ Basement w/plumbing ☐ Basement wo/plumbing

Water Supply: ☑ Individual ☐ Community ☐ Public

Comments: * ONE INSpection/observation port per LATERAL

Comments:

INITIAL SITE SKETCH 1"=50'

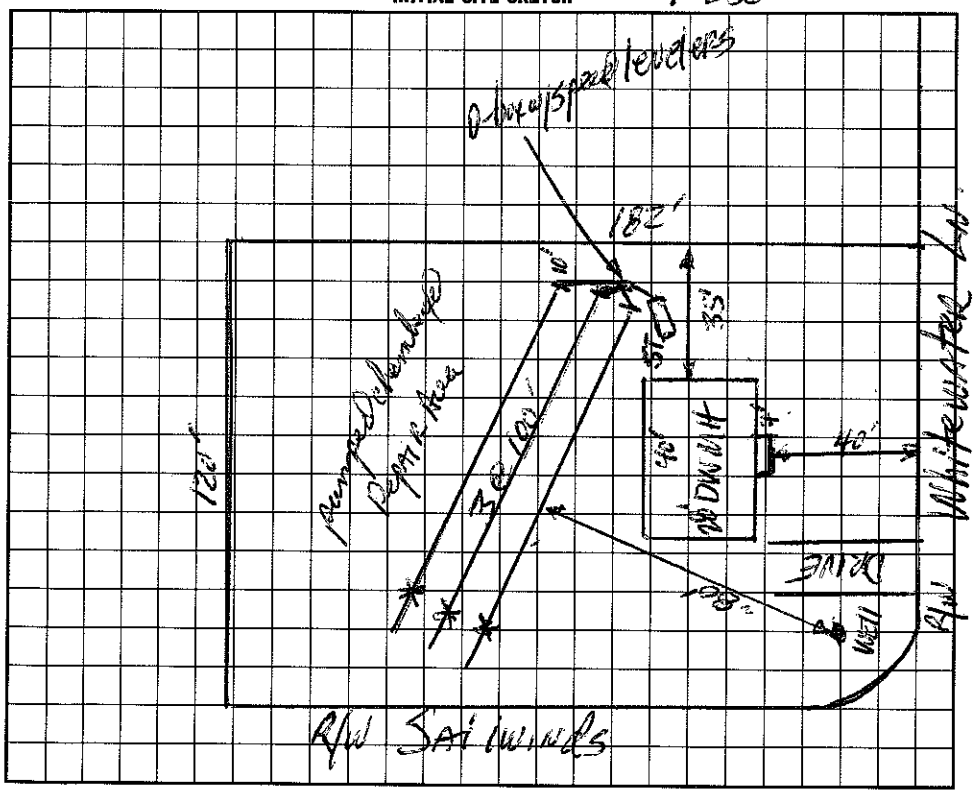

AS BUILT SKETCH

I understand that this permit can be suspended or revoked if any false information is supplied toward securing the permit/any unauthorized changes are made to the site/any unauthorized changes are made in the installation of the system. Improvement Permit is valid for 60 months from date of issuance.

Signed: *

Improvement Permit by: DRHammer RS date 6-7-97

~~Construction~~/~~Existing System~~ Inspection by: DRHammer RS date 6-7-97

Installed by: A1 BACKHOE

Certificate of Completion by: date

Operation Permit by: C Bailey Farmer date 3/6/98

~~HEALTH~~ DEPT. COPY: WHITE INSPECTION COPY (FINAL): GREEN OWNER COPY (FINAL): YELLOW INSPECTION COPY (INITIAL): PINK OWNER COPY (INITIAL): GOLD

Authorized