4659170453

IREDELL COUNTY HEALTH DEPARTMENT Const. Auth STATESVILLE 704-878-5305 MOORESVILLE 704-664-5281

IMPROVEMENT PERMIT / ~~CERTIFICATE OF COMPLETION~~ / OPERATION PERMIT / EXISTING SYSTEM INSPECTION

PROPERTY DESCRIPTION NO. 24857 DATE Nov. 16, '96 TAX MAP NO. part of 4EH12 Watershed: ☑ Yes ☐ No

OWNER OR CONTRACTOR Smith Dev. Co / Integrity Homes PHONE: Business 875-[illegible]81 Home

ADDRESS 13420 Reese Blvd W. Huntersville NC 28078

LOCATION US 21 N to Sailboats on the Right of the 1st lot

SUBDIVISION Windward Pt. BLOCK / SECTION ____ LOT 8 LOT AREA 120'X175' SITE CLASS. PSpen.1996 DESIGN FLOW 360gpd L.T.A.R. ~.3

Septic Tank: 1000 Gallons; STB 794 Date 10-4-96

Pump Tank: ____ Gallons; PT ____ Date ____

Pump Make: ____ Model ____ Serial No. ____

Nitrification Field: No Fields 1 Square Feet 900 Linear Feet 300

No Lines 3@100 Trench Width 36" Max Trench Bottom Depth 36" Gravel Depth N/A

☑ New System ☐ Repair System Type: I, II, III, IV, V, VI

System Description: Gravity plastic chamber

Repair System Description: same

Maintenance Agreement Required: ☐ Yes ☑ No

☑ House/Mod. Home No. Bedrooms 3

☐ Mobile Home No. Bathrooms 2

☐ Business No. Employees ____

☐ Other ____

☐ Slab ☑ Crawl Space ☐ Basement w/plumbing ☐ Basement wo/plumbing


Water Supply: ☑ Individual ☐ Community ☐ Public

Comments:

Comments: Well not in place at time of inspection.

1"=50'

INITIAL SITE SKETCH

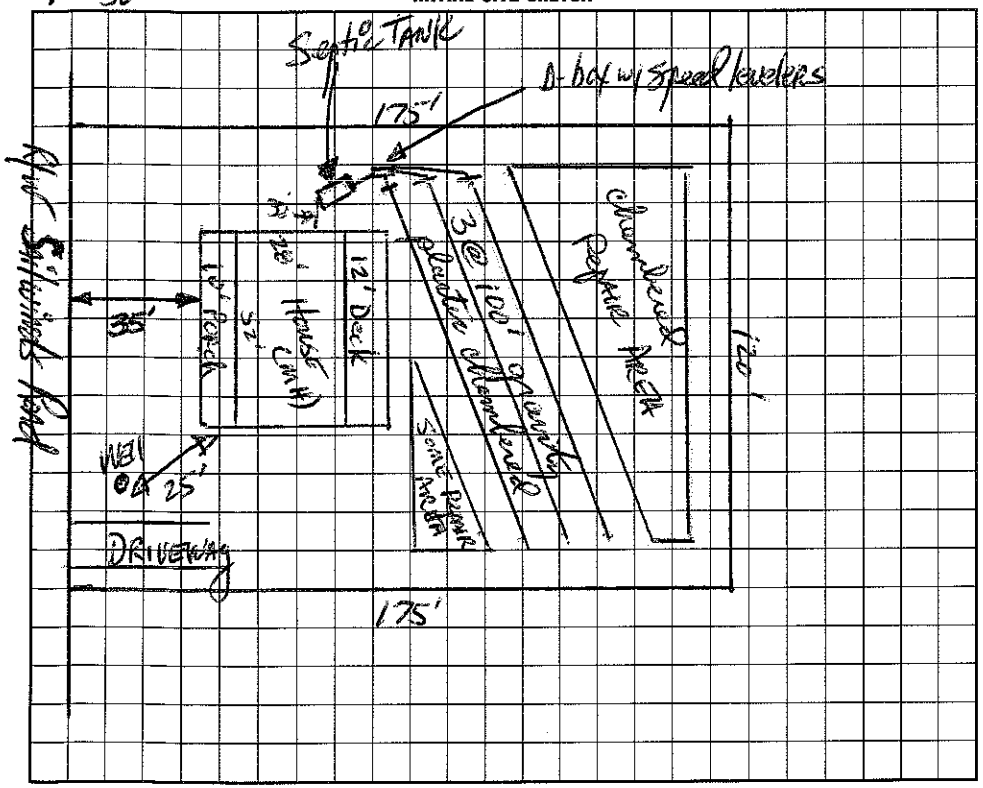

AS BUILT SKETCH

Same as Site Sketch

I understand that this permit can be suspended or revoked if any false information is supplied toward securing the permit/any unauthorized changes are made to the site/any unauthorized changes are made in the installation of the system.

Signed: ~~X~~ Russell J. Wilson

Improvement Permit by: [signature], RS date 11-18-96

~~Existing System~~ Construction Inspection by: [signature], RS date 11-18-96

Authorization

Installed by: TIM AMMONS

Certificate of Completion by: ____ date ____

Operation Permit by: [signature] date 12/4/96

HEALTH DEPT. COPY: WHITE INSPECTION COPY (FINAL): GREEN OWNER COPY (FINAL): YELLOW INSPECTION COPY (INITIAL): PINK OWNER COPY (INITIAL): GOLD