IREDELL COUNTY HEALTH DEPARTMENT

STATESVILLE 704-878-5305 MOORESVILLE 704-664-5281

IMPROVEMENT PERMIT / AUTHORIZATION TO CONSTRUCT / OPERATION PERMIT / EXISTING SYSTEM INSPECTION

PERMIT# 24856 PIN# 4EA12 4059171475 DATE 4/15/98

OWNER OR CONTRACTOR Pruett Development Co PHONE: Business 875-0081 Home

ADDRESS 13420 Reese Blvd. W Huntersville NC 28078

LOCATION 115- 24 TL Sailwinds to 7th lot on (R)

SUBDIVISION Windward Point BLOCK / SECTION LOT 7 LOT AREA 21780 SITE CLASS. PS DESIGN FLOW 360 L.T.A.R. .3

Septic Tank: 1000 Gallons; STB 1012 Date 2/17/98
Pump Tank: Gallons; PT Date
Pump Make: Model Serial No.
Nitrification Field; No Fields 1 Square Feet 900* Linear Feet 300*
No Lines 4 Trench Width 36" Max Trench Bottom Depth 36" Gravel Depth SAND

☒ New System ☐ Repair System Type: I, II, (III) IV, V, VI
System Description: GRAV - CH PLASTIC
Repair System Description: GRAV - PPBS 16"
Maintenance Agreement Required: ☐ Yes ☒ No


☒ House/Mod. Home No. Bedrooms 3
☐ Mobile Home No. Bathrooms 2
☐ Business No. Employees
☐ Other
☐ Slab ☒ Crawl Space ☐ Basement w/plumbing ☐ Basement wo/plumbing

Water Supply:
☒ Individual
☐ Public
☐ Community

Comments:/Conditions: * 25% Reduction for use of Chamber Plastic Drainfield

Comments:/Conditions:

INITIAL SITE SKETCH

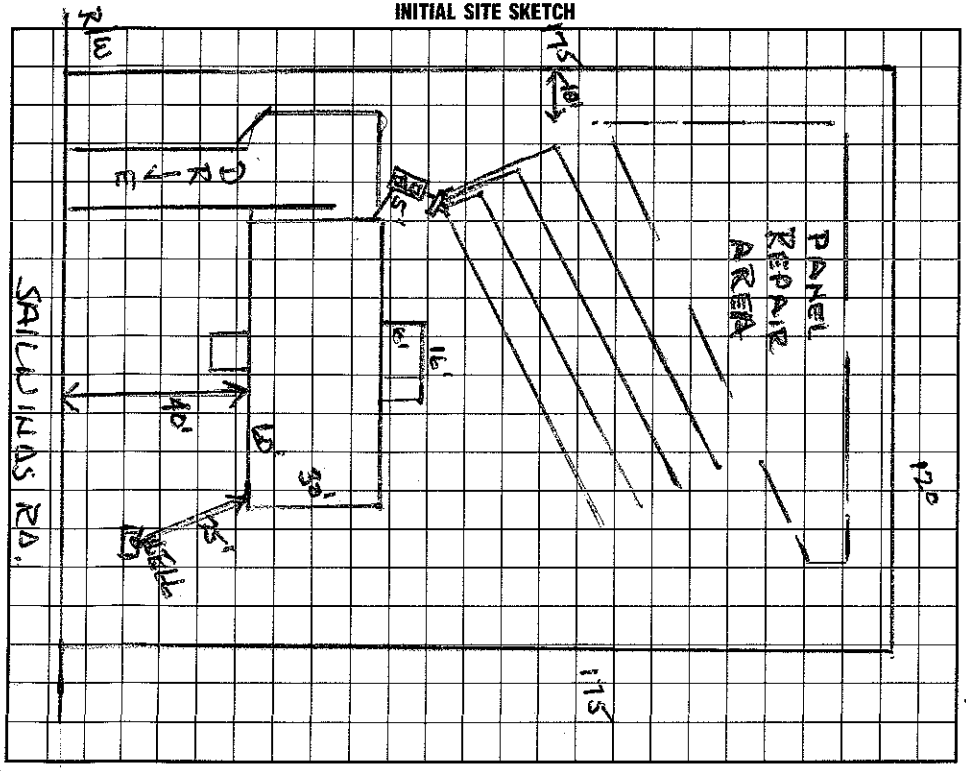

AS BUILT SKETCH

I understand that this permit can be suspended or revoked if any false information is supplied toward securing the permit/any unauthorized changes are made to the site/any unauthorized changes are made in the installation of the system. Improvement Permit with plat valid without expiration. Improvement Permit with site plan valid for sixty months. Authorization to Construct is valid for a period equal to that of Improvement Permit – not to exceed sixty months.

Signed: * date

Improvement Permit by: Wesley Sparks R.S. date 4/15/98

Authorization to Construct by: Wesley Sparks R.S. date 4/15/98

Installed by: A I BACKHOE

Operation Permit by: date

Existing System Inspection by: C. [illegible] date 4/24/98

HEALTH DEPT. COPY: WHITE INSPECTION COPY (FINAL): GREEN OWNER COPY (FINAL): YELLOW INSPECTION COPY (INITIAL): PINK OWNER COPY (INITIAL): GOLD