IREDELL COUNTY HEALTH DEPARTMENT

STATESVILLE 704-878-5305 MOORESVILLE 704-664-5281

4659171969

IMPROVEMENT PERMIT / CERTIFICATE OF COMPLETION / OPERATION PERMIT / EXISTING SYSTEM INSPECTION

PROPERTY DESCRIPTION NO. _____ DATE 5-12-93

OWNER ~~OR CONTRACTOR~~ GENEVA HARRILL PHONE: Business _____ TAX MAP NO. NA

ADDRESS _____ Home 528-5003

LOCATION 115 N 3/10 Mi N OF WESTMORELAND RD - FIRST brick Hse on LEFT (WEST SIDE)

SUBDIVISION _____ BLOCK / SECTION _____ LOT _____ LOT AREA _____ SITE CLASS. P L.T.A.R. 0.3

Water Supply: ☑ Individual ☐ Community ☐ Public

Septic Tank: 1000 Gallons; STB _____ Date EXISTING

Pump Tank: _____ Gallons; PT _____ Date _____

Nitrification Field: ~~No Fields~~ 6x10 BED Square Feet 650' Linear Feet 180'

No Lines _____ Trench Width _____ Trench Depth _____ Gravel Depth 16-17"

☐ New System ☐ Repair System Type: I, II, III, IV, V, VI

System Description: _____

Repair System Description: _____

Maintenance Agreement Required: ☐ Yes ☒ No

☒ House/Mod. Home No. Bedrooms 3

☐ Mobile Home No. Bathrooms 2

☐ Business No. Employees _____

☐ Other _____

Garbage Disposal: ☐ Yes ☑ No

Auto. Dishwasher: ☑ Yes ☐ No

Auto. Washing Machine: ☑ Yes ☐ No


Other _____

☐ Slab ☐ Crawl Space ☑ Basement w/plumbing ☐ Basement wo/plumbing

Comments Keep shallow as possible. Old gutter drains removed from top of septic tank.

INITIAL SITE SKETCH

AS BUILT SKETCH

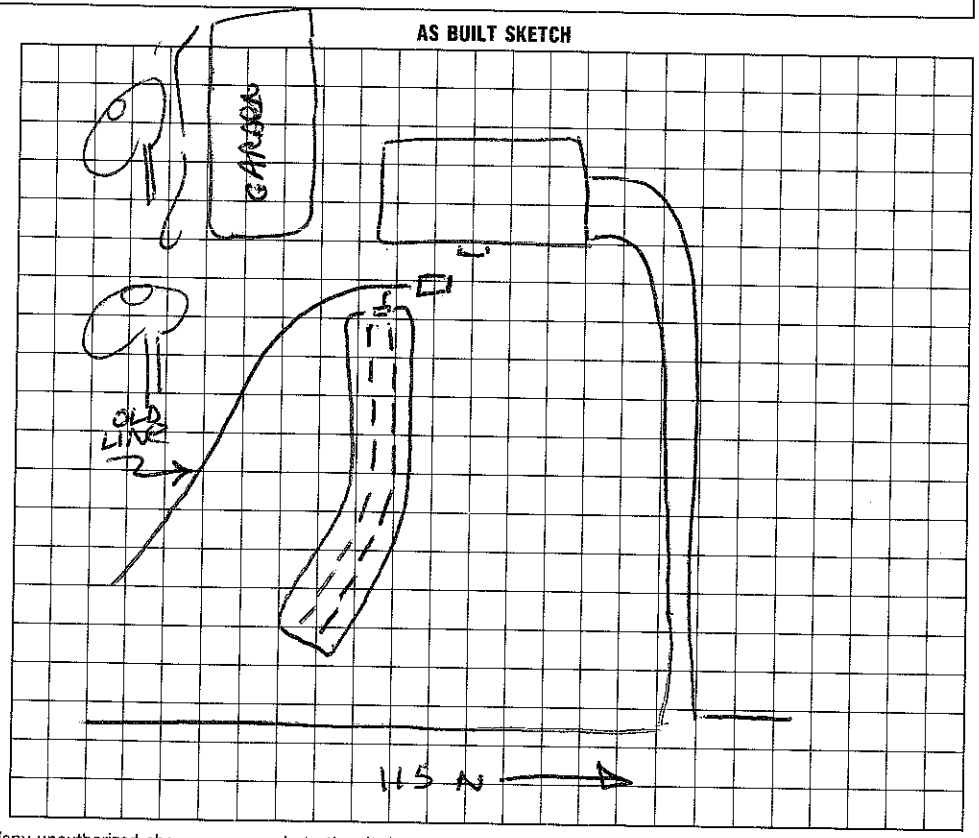

I understand that this permit can be suspended or revoked if any false information is supplied toward securing the permit/any unauthorized changes are made to the site/any unauthorized changes are made in the installation of the system. Improvement Permit is valid for 60 months from date of issuance.

Signed: _____

Improvement Permit by: WESLEY SPARKS date _____

Existing System Inspection by: _____ date _____

Installed by: _____

Certificate of Completion by: Andrea Lemon date 6-2-93

Operation Permit by: _____ date _____

HEALTH DEPT. COPY: WHITE INSPECTION COPY (FINAL): GREEN OWNER COPY (FINAL): YELLOW INSPECTION COPY (INITIAL): PINK OWNER COPY (INITIAL): GOLD