10:00 4659172094

IREDELL COUNTY HEALTH DEPARTMENT

Cons. Auth. STATESVILLE 704-878-5305 MOORESVILLE 704-664-5281

IMPROVEMENT PERMIT / ~~CERTIFICATE OF COMPLETION~~ / OPERATION PERMIT / EXISTING SYSTEM INSPECTION

PROPERTY DESCRIPTION NO. 24908 DATE March 6, '97 TAX MAP NO. part of 4EA12 Watershed: ☑ Yes ☐ No

OWNER OR CONTRACTOR Truitt Dev. Co. PHONE: Business _____ Home _____

ADDRESS 142 Stella Rd, Mooresville

LOCATION 21 N. TL Sailwinds TL Rosetta Ln. on Right

SUBDIVISION Windward PH. BLOCK / SECTION _____ LOT 59 LOT AREA 120' X 182' SITE CLASS. PSpr.1996 DESIGN FLOW 360 gpd L.T.A.R. .3

Septic Tank: 1000 Gallons; STB 526 Date 2/5/97

Pump Tank: _____ Gallons; PT _____ Date _____

Pump Make: _____ Model _____ Serial No. _____

Nitrification Field: No Fields 1 Square Feet 900 Linear Feet 300

No Lines 4@75' Trench Width 36" Max Trench Bottom Depth 36" Gravel Depth NA

☑ New System ☐ Repair System Type: I, II, (III), IV, V, VI

System Description: gravity plastic chambered

Repair System Description: gravity pumped chamb/PPBPS

Maintenance Agreement Required: ☐ Yes ☐ No

☐ House/Mod. Home No. Bedrooms 3

☑ Mobile Home No. Bathrooms 2

☐ Business No. Employees _____

☐ Other _____

☐ Slab ☑ Crawl Space ☐ Basement w/plumbing ☐ Basement wo/plumbing


Water Supply: ☑ Individual ☐ Community ☐ Public

Comments:


Comments: WELL NOT LOCATED AT INSPECTION 3/7/97 C.R.S.

INITIAL SITE SKETCH

1" = 50'

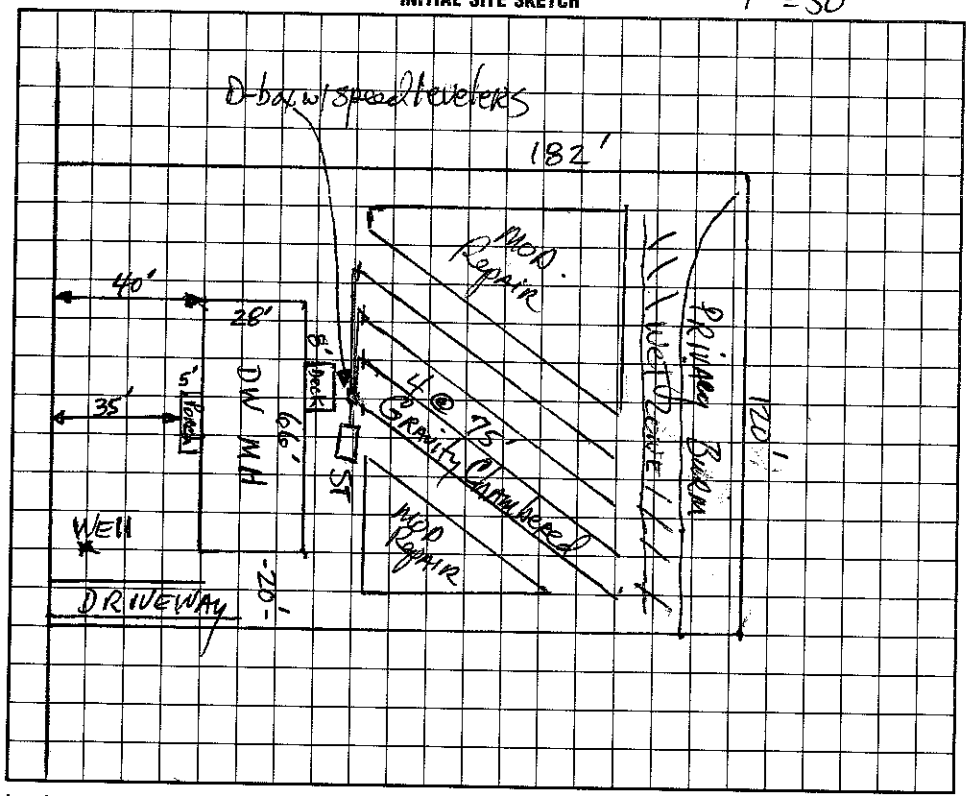

AS BUILT SKETCH

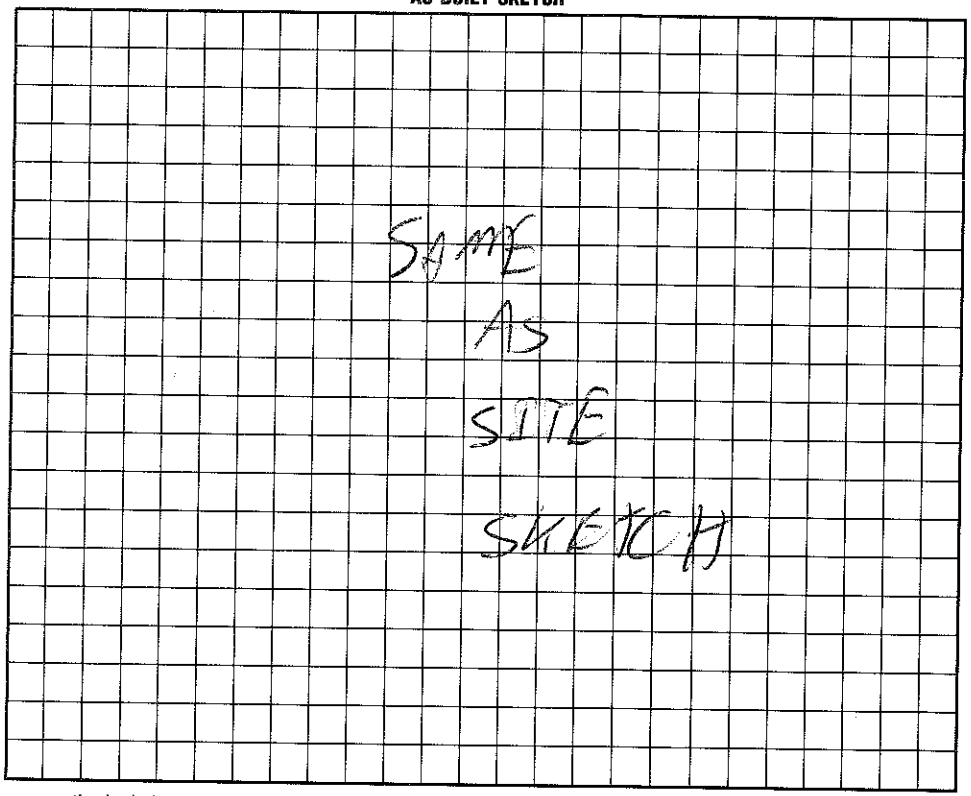

I understand that this permit can be suspended or revoked if any false information is supplied toward securing the permit/any unauthorized changes are made to the site/any unauthorized changes are made in the installation of the system. Improvement Permit is valid for 60 months from date of issuance.

Signed: _____

Improvement Permit by: D R Thomson, RS date 3/6/97

~~Existing System Inspection~~ Construction Authorization by: D R Thomson, RS date 3/6/97

Installed by: G & M Enterprises

Certificate of Completion by: _____ date _____

Operation Permit by: _____ date 3/7/97

HEALTH DEPT. COPY: WHITE INSPECTION COPY (FINAL): GREEN OWNER COPY (FINAL): YELLOW INSPECTION COPY (INITIAL): PINK OWNER COPY (INITIAL): GOLD