(4:00) 4659172176

IREDELL COUNTY HEALTH DEPARTMENT

Const. Auth. STATESVILLE 704-878-5305 MOORESVILLE 704-664-5281

IMPROVEMENT PERMIT / ~~CERTIFICATE OF COMPLETION~~ / OPERATION PERMIT / EXISTING SYSTEM INSPECTIO

PROPERTY DESCRIPTION NO. 24907 DATE Feb 12, '97 TAX MAP NO. part of 4EA12 Watershed: ☑ Yes ☐ No

OWNER OR CONTRACTOR Pruitt Dev. Co. PHONE: Business ______ Home ______

ADDRESS 142 Statts Rd. Mooresville

LOCATION 115-21 N TL Sailwinds TL Regatta Ln. 2nd lot on Right

SUBDIVISION Windward Pt. BLOCK / SECTION ______ LOT 58 LOT AREA 120' x 182' SITE CLASS. PS per. 1956 DESIGN FLOW 360 gpd L.T.A.R. .3

Septic Tank: 1000 Gallons; STB 826 Date 1/29/97

Pump Tank: ______ Gallons; PT ______ Date ______

Pump Make: ______ Model ______ Serial No. ______

Nitrification Field: No Fields 1 Square Feet 900 Linear Feet 300

No Lines 3 @ 100' Trench Width 36" Max Trench Bottom Depth 36" Gravel Depth NA

☑ New System ☐ Repair System Type: I, II, (III), IV, V, VI

System Description: gravity chambered

Repair System Description: gravity / pumped panel Blk

Maintenance Agreement Required: ☐ Yes ☑ No

☐ Slab ☑ Crawl Space ☐ Basement w/plumbing ☐ Basement wo/plumbing

☐ House/Mod. Home ☑ Mobile Home ☐ Business ☐ Other ______

No. Bedrooms 3 No. Bathrooms 2 No. Employees ______


Water Supply: ☑ Individual ☐ Community ☐ Public

Comments:

Comments:

1" = 50'

INITIAL SITE SKETCH

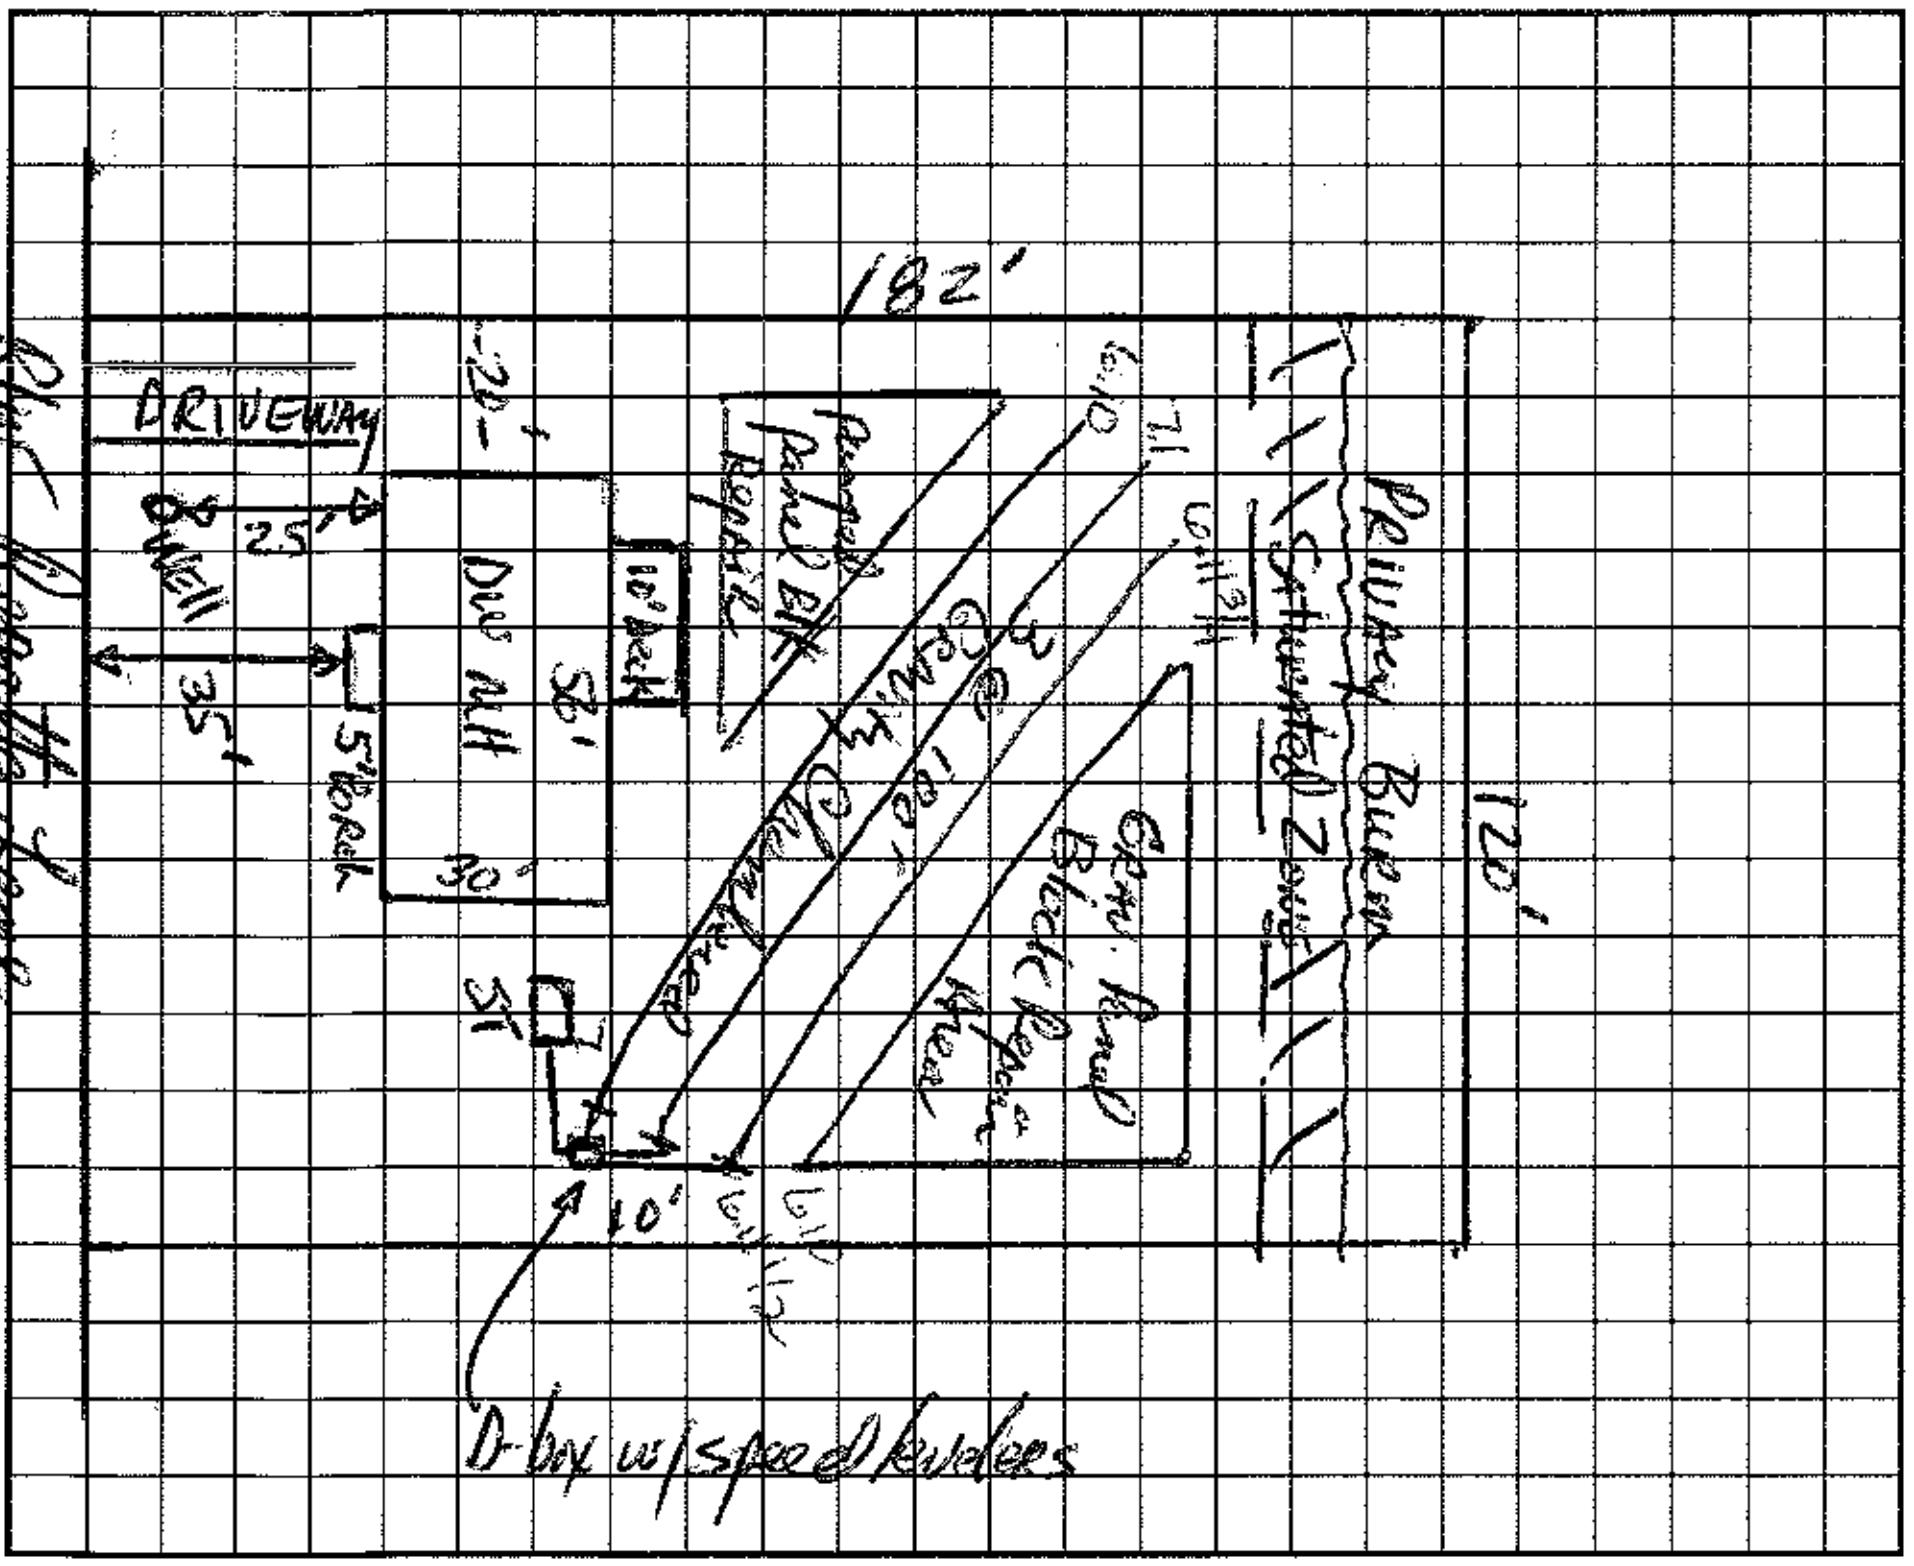

AS BUILT SKETCH

SAME AS SITE SKETCH

I understand that this permit can be suspended or revoked if any false information is supplied toward securing the permit/any unauthorized changes are made to the site/any unauthorized changes are made in the installation of the system. Improvement Permit is valid for 60 months from date of issuance.

Signed: [signature]

Installed by: G & M ENTERPRISES

Improvement Permit by: [signature], RS date 2-12-97

Certificate of Completion by: ______ date ______

Construction Authorization ~~Existing System Inspection~~ by: [signature], RS date 2-12-97

Operation Permit by: [signature] date 3/5/97

HEALTH DEPT. COPY: WHITE INSPECTION COPY (FINAL): GREEN OWNER COPY (FINAL): YELLOW INSPECTION COPY (INITIAL): PINK OWNER COPY (INITIAL): GOLD