4659172497

IREDELL COUNTY HEALTH DEPARTMENT Const. Auth.

STATESVILLE 704-878-5305 MOORESVILLE 704-664-5281

IMPROVEMENT PERMIT / ~~CERTIFICATE OF COMPLETION~~ / OPERATION PERMIT / EXISTING SYSTEM INSPECTION

PROPERTY DESCRIPTION NO. 24853 DATE April 19, '97 TAX MAP NO. part of 4EA12

OWNER OR CONTRACTOR Pruitt Dev. Co. PHONE: Business Home

ADDRESS 142 Stilly Rd Mooresville Watershed: ☒ ~~Yes~~ ☐ No

LOCATION 2 i N. Tl Salisbury Crk on Right

SUBDIVISION Windward PT BLOCK / SECTION LOT 6 LOT AREA .48Ac SITE CLASS. 15 DESIGN FLOW 360gpd L.T.A.R. .3

Septic Tank: 1000 Gallons; STB 821-Mull Date 6-30-97

Pump Tank: Gallons; PT Date

Pump Make: Model Serial No.

Nitrification Field: No Fields 1 Square Feet 900 Linear Feet 300

No Lines 3 @ 100 Trench Width 36" Max Trench Bottom Depth 36" Gravel Depth NA

☒ New System ☐ Repair System Type: I, II, (III), IV, V, VI

System Description: gravity chambered

Repair System Description: same

Maintenance Agreement Required: ☐ Yes ☒ No

☐ House/Mod. Home ☒ Mobile Home ☐ Business ☐ Other

No. Bedrooms 3 No. Bathrooms 2 No. Employees

☐ Slab ☒ Crawl Space ☐ Basement w/plumbing ☐ Basement wo/plumbing


Water Supply: ☒ Individual ☐ Community ☐ Public

Comments: Asphalt cap inspection port per chambered lateral located ~3/4 way down each trench.

Comments: 7-29-97 Well not drilled; DWMH not on site installed substantially as shown on initial sketch

1"=50'

INITIAL SITE SKETCH

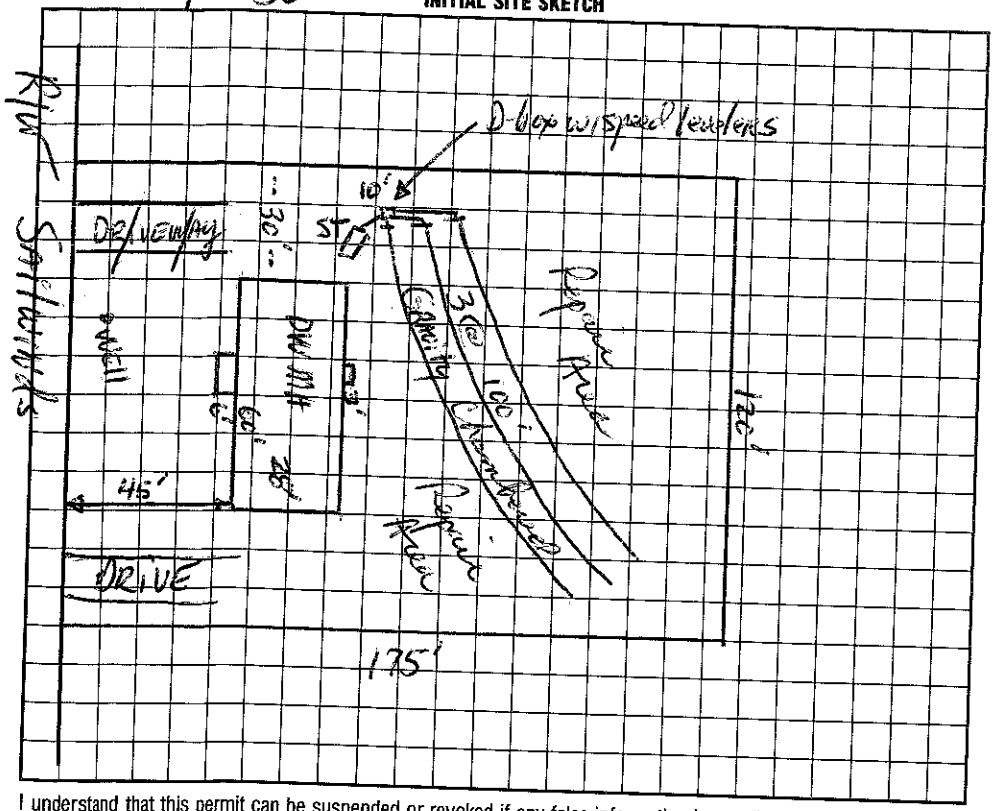

AS BUILT SKETCH

I understand that this permit can be suspended or revoked if any false information is supplied toward securing the permit/any unauthorized changes are made to the site/any unauthorized changes are made in the installation of the system. Improvement Permit is valid for 60 months from date of issuance.

Signed: #

Improvement Permit by: DRHuman RS date 4/19/97

~~Existing System Inspection by:~~ DRHuman RS date 4/19/97

Installed by: G&M

Certificate of Completion by: date

Operation Permit by: DRHuman RS date 7-29-97

HEALTH DEPT. COPY: WHITE INSPECTION COPY (FINAL): GREEN OWNER COPY (FINAL): YELLOW INSPECTION COPY (INITIAL): PINK OWNER COPY (INITIAL): GOLD

Rev. 12/12/96