4659174419

IREDELL COUNTY HEALTH DEPARTMENT

Const. Auth. STATESVILLE 704-878-5305 MOORESVILLE 704-664-5281

IMPROVEMENT PERMIT / ~~CERTIFICATE OF COMPLETION~~ / OPERATION PERMIT / EXISTING SYSTEM INSPECTION

PROPERTY DESCRIPTION NO. 24854 DATE November 18, '96 TAX MAP NO. part of 4E A12 Watershed: ☑ Yes ☐ No

OWNER OR CONTRACTOR Truitt Dev. Co / Integrity Homes PHONE: Business 875-0081 Home WS IV CA

ADDRESS 13420 Reese Blvd W. Huntersville NC 28078

LOCATION US 21 N TL Sattawhite Rd. 5th lot on Right

SUBDIVISION Windward Pt. BLOCK / SECTION ____ LOT 5 LOT AREA 120x175' SITE CLASS. PSpec. 1952 DESIGN FLOW 360 gpd L.T.A.R. n.a. 3

Septic Tank: 1000 Gallons; STB ____ Date 5/25/96

Pump Tank: ____ Gallons; PT ____ Date ____

Pump Make: ____ Model ____ Serial No. ____

Nitrification Field: No Fields 1 Square Feet 900 Linear Feet 300

No Lines 3 @ 100' Trench Width 36" Max Trench Bottom Depth 36" Gravel Depth NA

☑ New System ☐ Repair System Type: I, II, (III), IV, V, VI

System Description: gravity plastic chambered

Repair System Description: same

Maintenance Agreement Required: ☐ Yes ☑ No

☐ House/Mod. Home ☑ Mobile Home ☐ Business ☐ Other ____

No. Bedrooms 3 No. Bathrooms 2 No. Employees ____


☐ Slab ☑ Crawl Space ☐ Basement w/plumbing ☐ Basement wo/plumbing

Water Supply: ☑ Individual ☐ Community ☐ Public

Comments:

Comments:

INITIAL SITE SKETCH 1" = 50'

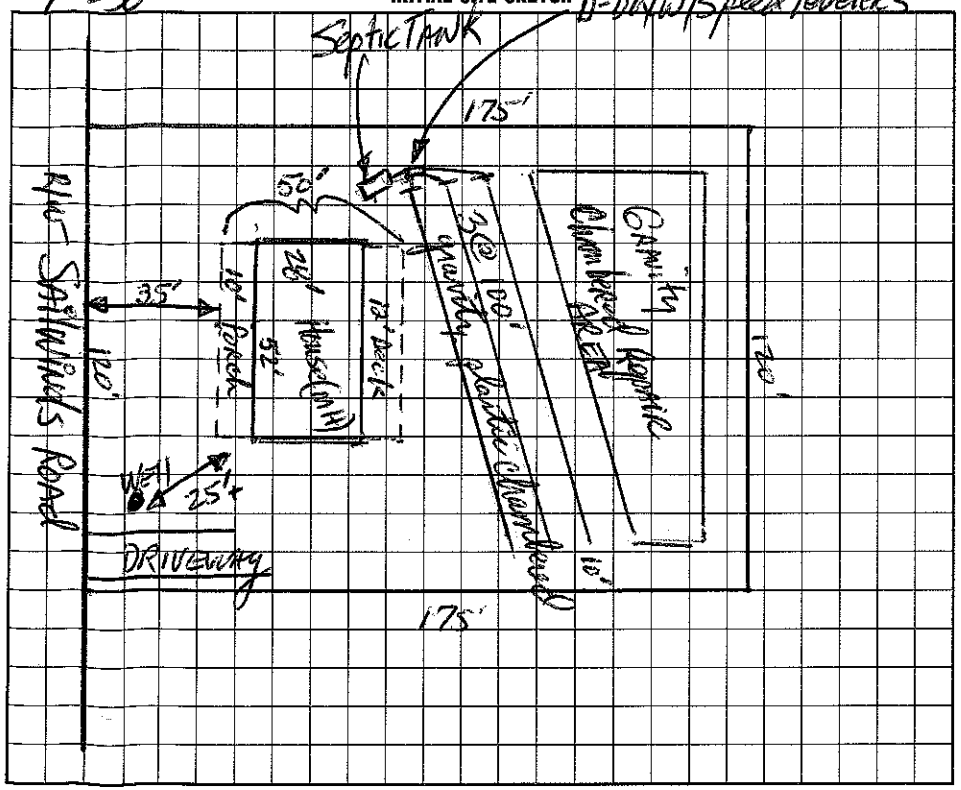

AS BUILT SKETCH

I understand that this permit can be suspended or revoked if any false information is supplied toward securing the permit/any unauthorized changes are made to the site/any unauthorized changes are made in the installation of the system.

Signed: Russell Abernathy

Improvement Permit by: Wayne B. Harrison, RS date 11-18-96

~~Existing System Inspection~~ Construction Authorization by: Wayne B. Harrison, RS date 11-18-96

Installed by: Tim Ammons

Certificate of Completion by: ____ date ____

Operation Permit by: Wesley Sparks RS date 11/27/96

HEALTH DEPT. COPY: WHITE INSPECTION COPY (FINAL): GREEN OWNER COPY (FINAL): YELLOW INSPECTION COPY (INITIAL): PINK OWNER COPY (INITIAL): GOLD