4659175522

IREDELL COUNTY HEALTH DEPARTMENT Const. Auth

STATESVILLE 704-878-5305 MOORESVILLE 704-664-5281

IMPROVEMENT PERMIT / ~~CERTIFICATE OF COMPLETION~~ / OPERATION PERMIT / EXISTING SYSTEM INSPECTION

PROPERTY DESCRIPTION NO. 24853 DATE Feb 27, '97 TAX MAP NO. part of 4EA12 Watershed: ☑ Yes ☐ No

OWNER OR CONTRACTOR Pruitt Dev Co. PHONE: Business _____ Home _____

ADDRESS 142 Stults Rd Mooresville 4th lot on Right

LOCATION 21N to Sailwinds

SUBDIVISION Windward Pt. BLOCK / SECTION _____ LOT 4 LOT AREA 120 X 175' SITE CLASS. PS per 1996 DESIGN FLOW 360 gpd L.T.A.R. .3

Septic Tank: 1000 Gallons; STB 1012 Date 7/23/98

Pump Tank: _____ Gallons; PT _____ Date _____

Pump Make: _____ Model _____ Serial No. _____

Nitrification Field: No Fields 1 Square Feet 900 Linear Feet 300

No Lines 3@100' Trench Width 36" Max Trench Bottom Depth 24" Gravel Depth NA

☑ New System ☐ Repair System Type: I, II, III, IV, V, VI

System Description: gravity plastic chamber

Repair System Description: same

Maintenance Agreement Required: ☐ Yes ☑ No

☐ House/Mod. Home ☑ Mobile Home ☐ Business ☐ Other

No. Bedrooms 3 No. Bathrooms 2 No. Employees ____


☐ Slab ☑ Crawl Space ☐ Basement w/plumbing ☐ Basement wo/plumbing

Water Supply: ☐ Individual ☐ Community ☐ Public

Comments: 102 102 108

Comments:

INITIAL SITE SKETCH

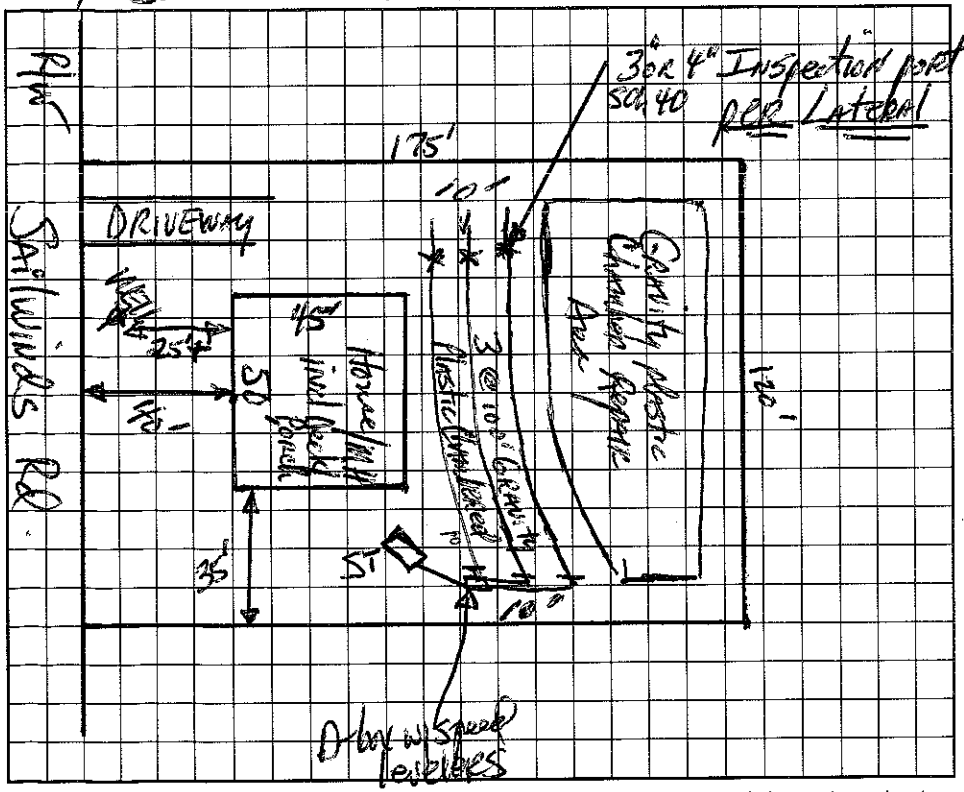

AS BUILT SKETCH

I understand that this permit can be suspended or revoked if any false information is supplied toward securing the permit/any unauthorized changes are made to the site/any unauthorized changes are made in the installation of the system. Improvement Permit is valid for 60 months from date of issuance.

_____ date 2/27/97 2/27/97

Installed by: A1 BACKHOE

Certificate of Completion by: _____ date _____

Operation Permit by: _____ RS date 9/23/98

WHITE: YELLOW INSPECTION COPY (INITIAL): PINK OWNER COPY (INITIAL): GOLD