4659176365

IREDELL COUNTY HEALTH DEPARTMENT

Const Auth · STATESVILLE 704-878-5305 MOORESVILLE 704-664-5281

IMPROVEMENT PERMIT / ~~CERTIFICATE OF COMPLETION~~ / OPERATION PERMIT / EXISTING SYSTEM INSPECTION

PROPERTY DESCRIPTION NO. 24921 DATE April 30, 1997 TAX MAP NO. part of 4EA12 Watershed: ☑ Yes ☐ No

OWNER OR CONTRACTOR Pruitt Dev. Co PHONE: Business / Home

ADDRESS 142 Stallard Rd, Mooresville

LOCATION I-77 exit 36 N to Sailwinds Dr, Keywest Cir. immediately on Right

SUBDIVISION Windward Pt BLOCK / SECTION LOT 72 LOT AREA 1.5 Ac SITE CLASS. RS DESIGN FLOW 360 gpd L.T.A.R. .3

Septic Tank: 1000 Gallons; STB 821 Date 5/14/97

Pump Tank: Gallons; PT Date

Pump Make: Model Serial No.

Nitrification Field: No Fields 1 Square Feet 900 Linear Feet 300

No Lines 4@75' Trench Width Max Trench Bottom Depth Gravel Depth

☐ New System ☐ Repair System Type: I, II, III, IV, V, VI

System Description: gravity Chambered

Repair System Description: Same

Maintenance Agreement Required: ☐ Yes ☐ No

☐ House/Mod. Home No. Bedrooms 3

☑ Mobile Home No. Bathrooms 2

☐ Business No. Employees

☐ Other


☐ Slab ☑ Crawl Space ☐ Basement w/plumbing ☐ Basement wo/plumbing

Water Supply: ☑ Individual ☐ Community ☐ Public

Comments:

Comments:

INITIAL SITE SKETCH 1"=50'

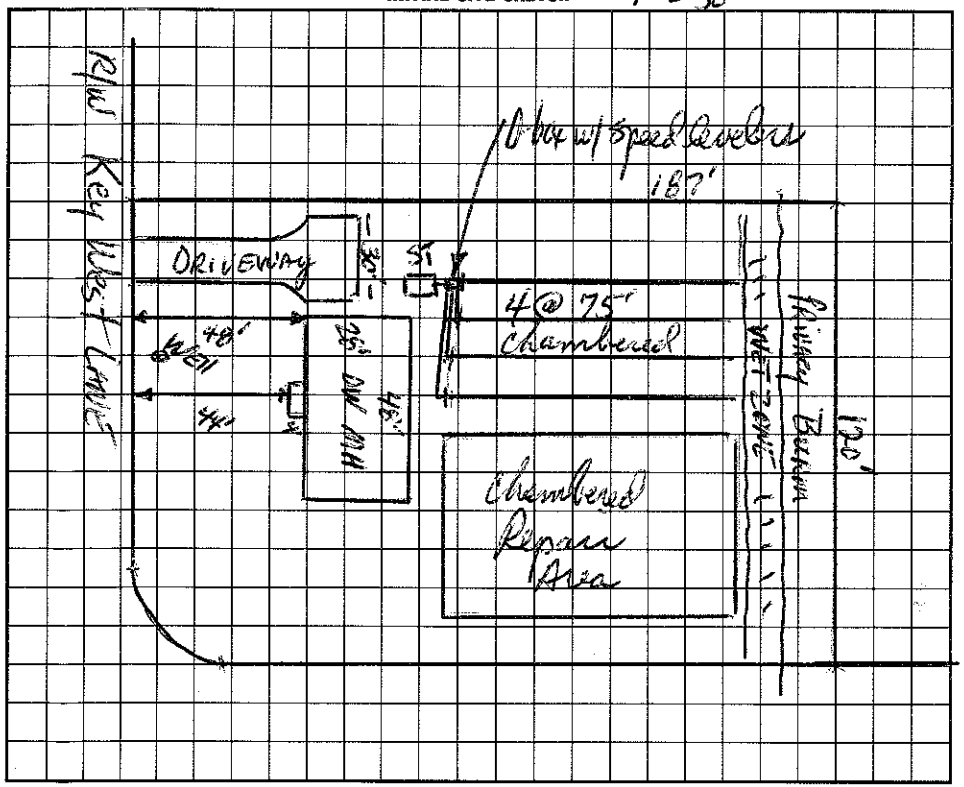

AS BUILT SKETCH

I understand that this permit can be suspended or revoked if any false information is supplied toward securing the permit/any unauthorized changes are made to the site/any unauthorized changes are made in the installation of the system. Improvement Permit is valid for 60 months from date of issuance.

Signed: *

Improvement Permit by: D.F. Hinson, RS date 4/30/97

~~Existing System Inspection by:~~ Construction Authorization D.F. Hinson, RS date 4/30/97

Installed by: D & M Enterprises

Certificate of Completion by: Wesley Hanks RS. date 6/4/97

Operation Permit by: Wesley Hanks RS. date 6/4/97

HEALTH DEPT. COPY: WHITE INSPECTION COPY (FINAL): GREEN OWNER COPY (FINAL): YELLOW INSPECTION COPY (INITIAL): PINK OWNER COPY (INITIAL): GOLD